IREDELL COUNTY HEALTH DEPARTMENT

Const. Auth. STATESVILLE 704-878-5305 MOORESVILLE 704-664-5281

IMPROVEMENT PERMIT / ~~CERTIFICATE OF COMPLETION~~ / OPERATION PERMIT / EXISTING SYSTEM INSPECTION

PROPERTY DESCRIPTION NO. 23360 DATE June 5, '96 TAX MAP NO. part of 2CA3 4626-31-7064 Watershed: ☑ Yes ☐ No

OWNER OR CONTRACTOR ~~Crescent Resources Corp.~~ SAUSSY BURBANK PHONE: Business _____ Home _____

ADDRESS P.O Box 1003, Charlotte

LOCATION Brawley Sch. Rd. TR Chuckwood TL Morrow's Ridge Ln. TR Wild Iris AT END

SUBDIVISION The Harbour BLOCK / SECTION III LOT 17 LOT AREA 20,000 ft² + SITE CLASS PS pen 1952 DESIGN FLOW ~~480 gpd~~ L.T.A.R. .3

Septic Tank: 1000 Gallons; STB 794 Date 2/24/99

Pump Tank: 1000 Gallons; PT 29 Date 3/19/99

Pump Make: HYDROMATIC Model SHEF-50A Serial No. 3/99

Nitrification Field: No Fields 1 Square Feet 1200 Linear Feet 400

No Lines 5 @ 80' Trench Width 36" Max Trench Bottom Depth 36" Gravel Depth NA

☑ New System ☐ Repair System Type: I, II, III, IV, V, VI

System Description: pumped - pm - chambered

Repair System Description: pumped - pm - chambered

Maintenance Agreement Required: ☐ Yes ☑ No

☑ House/Mod. Home ☐ Mobile Home ☐ Business ☐ Other

No. Bedrooms 4 No. Bathrooms 4 No. Employees ____

☐ Slab ☑ Crawl Space ☑ Basement w/plumbing ☐ Basement wo/plumbing


Water Supply: ☐ Individual ☐ Community ~~☑ Public~~

Comments:


Comments: PARTIAL

1" = 50'

INITIAL SITE SKETCH

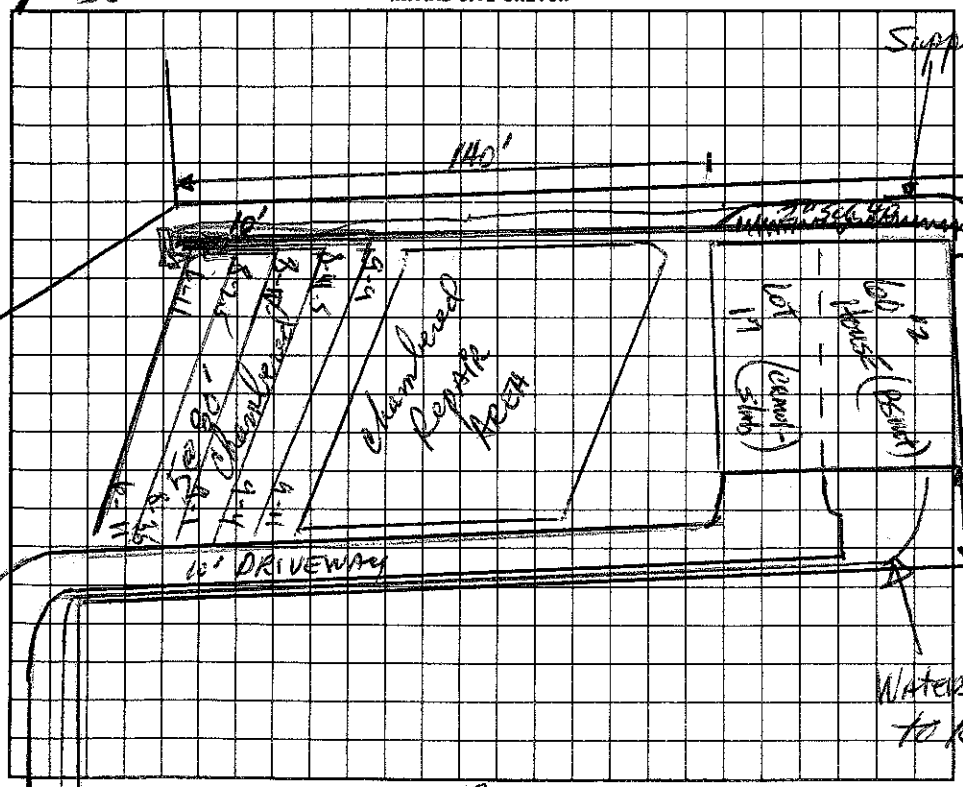

AS BUILT SKETCH

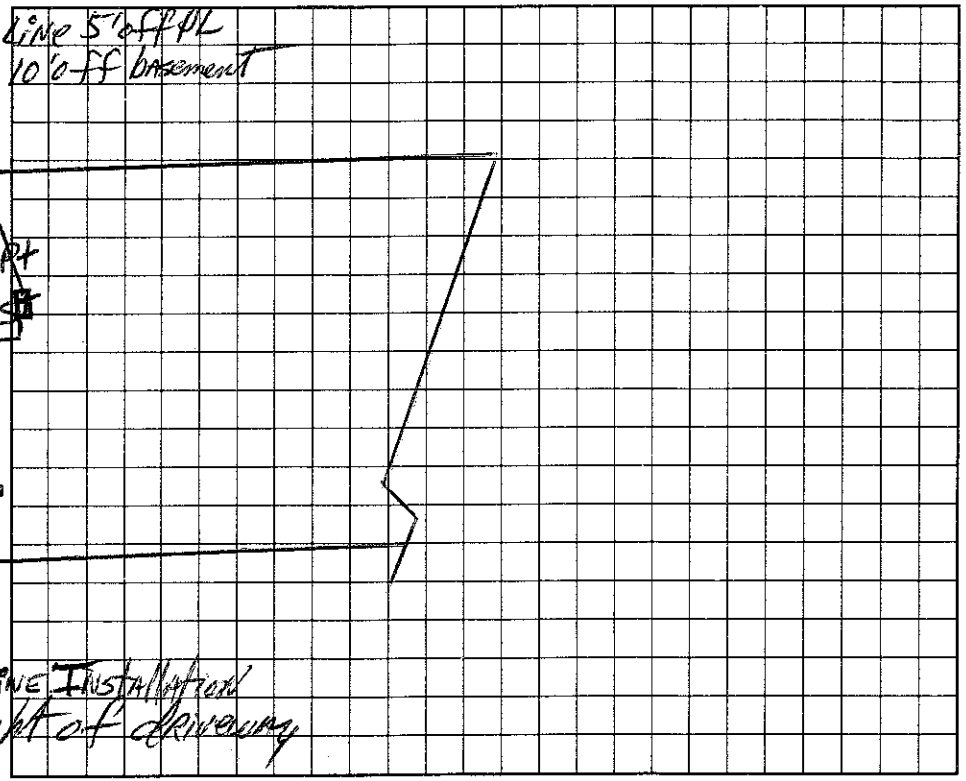

I understand that this permit can be suspended or revoked if any false information is supplied toward securing the permit/any unauthorized changes are made to the site/any unauthorized changes are made in the installation of the system.

Signed: Tony Caudle CAS

Improvement Permit by: Const. Auth. [illegible] RS date 6-5-96

~~Existing System Inspection by:~~ C. H. Zimmerman date 7/3/97

Installed by: Macleod Const. Co.

Certificate of Completion by: Wesley Sparks RS. date 5/10/99

Operation Permit by: Wesley Sparks RS. date 5/10/99

HEALTH DEPT. COPY: WHITE INSPECTION COPY (FINAL): GREEN OWNER COPY (FINAL): YELLOW INSPECTION COPY (INITIAL): PINK OWNER COPY (INITIAL): GOLD