IREDELL COUNTY HEALTH DEPARTMENT

STATESVILLE 704-878-5305 MOORESVILLE 704-664-5281

IMPROVEMENT PERMIT / CERTIFICATE OF COMPLETION / OPERATION PERMIT / EXISTING SYSTEM INSPECTION

PROPERTY DESCRIPTION NO. ~~T3~~ 19716 DATE 11/7/94 TAX MAP NO. 2F 6A 103 Watershed: ☐ Yes ☒ No

OWNER OR CONTRACTOR ~~Dina Hudson~~ RICHARD PROKOP PHONE: Business ~~[illegible]~~ Home 528-9449 AMS

ADDRESS LAKELAND DR. MOORESVILLE, NC. 28115

LOCATION Chadwood TR on Riviera TL on Lakeland to 2nd lot on L 4626-31-7862

SUBDIVISION Holiday Hills BLOCK / SECTION ____ LOT 103 LOT AREA .46AC SITE CLASS. P DESIGN FLOW 360 L.T.A.R. .3

Septic Tank: 1000 Gallons; STB 794 Date 10/22/94

Pump Tank: ____ Gallons; PT ____ Date ____

Pump Make: ____ Model ____ Serial No. ____

Nitrification Field: No Fields 1 Square Feet 1200 Linear Feet 400

No Lines 4 Trench Width 100 Max Trench Bottom Depth 36" Gravel Depth 12"

☒ New System ☐ Repair System Type: I, II, III, IV, V, VI

System Description: CONV - DIST BOX

Repair System Description: ____

Maintenance Agreement Required: ☐ Yes ☒ No

☒ House/Mod. Home No. Bedrooms 3

☐ Mobile Home No. Bathrooms 2

☐ Business No. Employees ____

☐ Other ____


☐ Slab ☒ Crawl Space ☐ Basement w/plumbing ☐ Basement wo/plumbing

Water Supply: ☒ Individual ☐ Community ☐ Public

Comments: Lines on slope contour indicated from sketch.
11/22/94 Owner changed - changes made in HD.

Comments: Installed as drawn

INITIAL SITE SKETCH

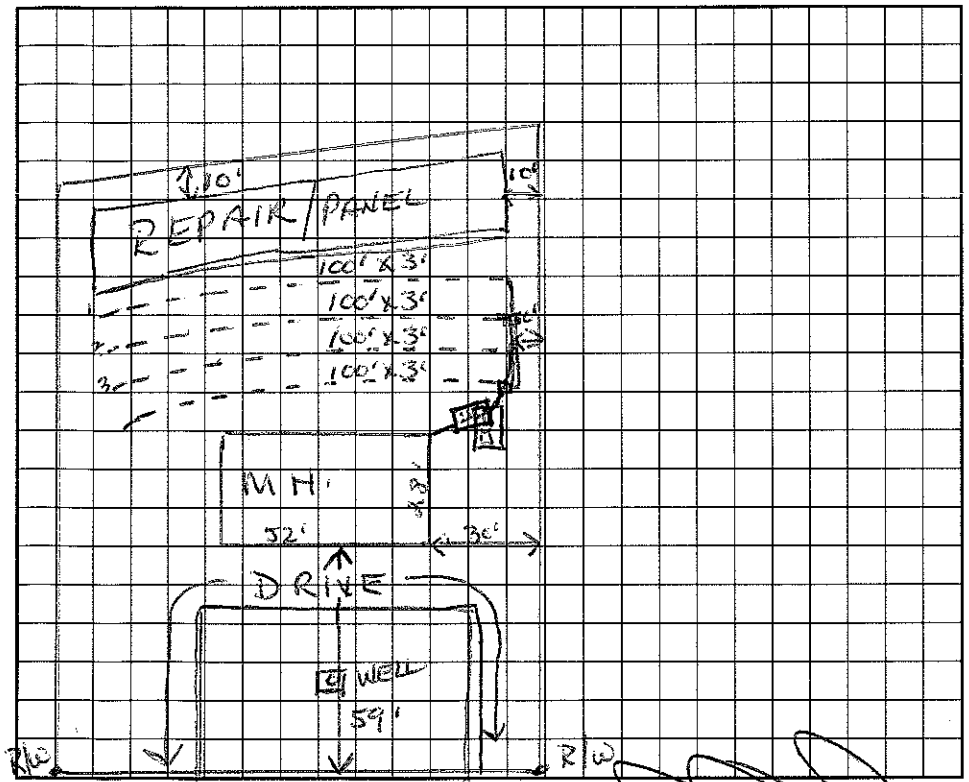

AS BUILT SKETCH

I understand that this permit can be suspended or revoked if any false information is supplied toward securing the permit/any unauthorized changes are made to the site/any unauthorized changes are made in the installation of the system. Improvement Permit is valid for 60 months from date of issuance.

Signed: [signature]

Improvement Permit by: Wesley Sparks R.S. date 11/7/94

Existing System Inspection by: ____ date ____

Installed by: Dennis Gaither

Certificate of Completion by: Wesley Sparks R.S. date 12/23/94

Operation Permit by: ____ date ____

HEALTH DEPT. COPY: WHITE INSPECTION COPY (FINAL): GREEN OWNER COPY (FINAL): YELLOW INSPECTION COPY (INITIAL): PINK OWNER COPY (INITIAL): GOLD