IREDELL COUNTY HEALTH DEPARTMENT

Const. Auth. STATESVILLE 704-878-5305 MOORESVILLE 704-664-5281

IMPROVEMENT PERMIT / ~~CERTIFICATE OF COMPLETION~~ / OPERATION PERMIT / EXISTING SYSTEM INSPECTION

PROPERTY DESCRIPTION NO. 23359 DATE June 5 '96 TAX MAP NO. part of 2CA3 4626318084 Watershed: ☑ Yes ☐ No

OWNER OR CONTRACTOR Crescent Resources, LLC (Stussy Burbank) PHONE: Business _____ Home _____

ADDRESS PO Box 1003 Charlotte

LOCATION Brawley Sch Rd. TR Chuckwood TL Morrow's Ridge Ln. TR Wild Iris At End

SUBDIVISION The Harbour BLOCK / SECTION III LOT 16 LOT AREA 20,000 +ff24 SITE CLASS. PExper. 1956 DESIGN FLOW 480 gpd L.T.A.R. .3

Septic Tank: 1000 Gallons; STB 794 Date 9/7/97

Pump Tank: 1000 Gallons; PT 27 Date 8/2/97

Pump Make: HYDROMATIC Model _____ Serial No. _____

Nitrification Field: No Fields 1 Square Feet 1200 Linear Feet 400

No Lines 5@80' Trench Width 36" Max Trench Bottom Depth 36" Gravel Depth NA

☑ New System ☐ Repair System Type: I, II, (III), IV, V, VI

System Description: pumped-pm-chambered LP PPBPS

Repair System Description: _____

Maintenance Agreement Required: ☐ Yes ☑ No initially

☑ House/Mod. Home No. Bedrooms 4

☐ Mobile Home No. Bathrooms 4

☐ Business No. Employees _____

☐ Other _____

☐ Slab ☑ Crawl Space ☑ Basement w/plumbing ☐ Basement wo/plumbing


Water Supply: ☐ Individual ☐ Community ☑ Public

Comments: SK LOMT 7-97


Comments: PARTIAL

1"=50'

INITIAL SITE SKETCH

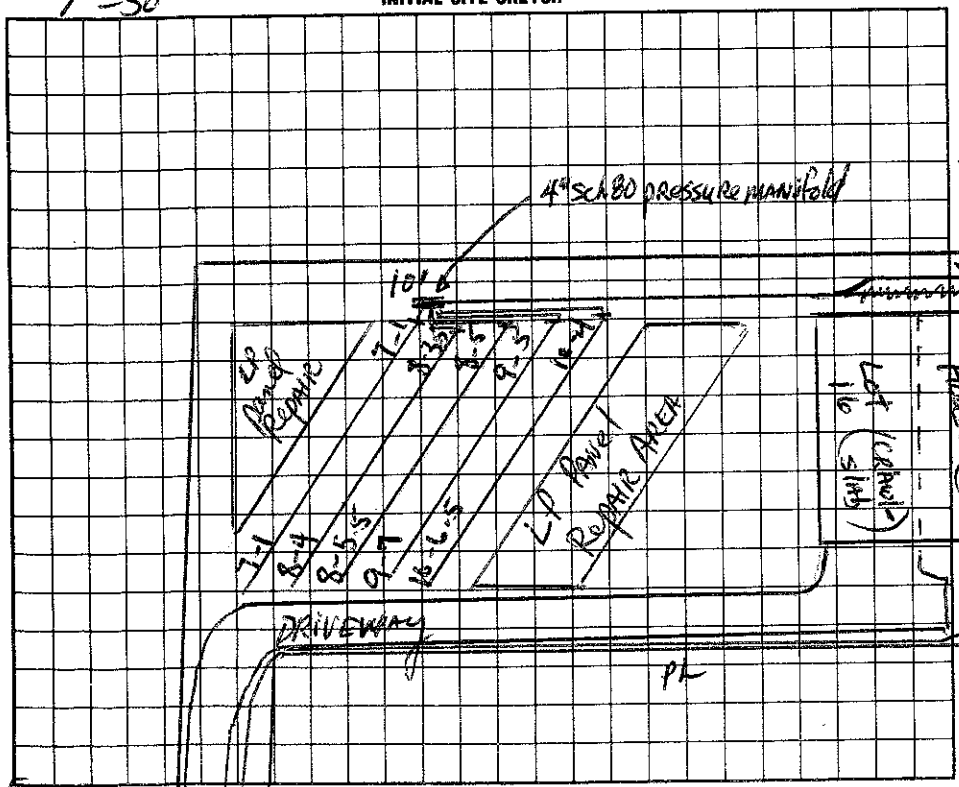

AS BUILT SKETCH

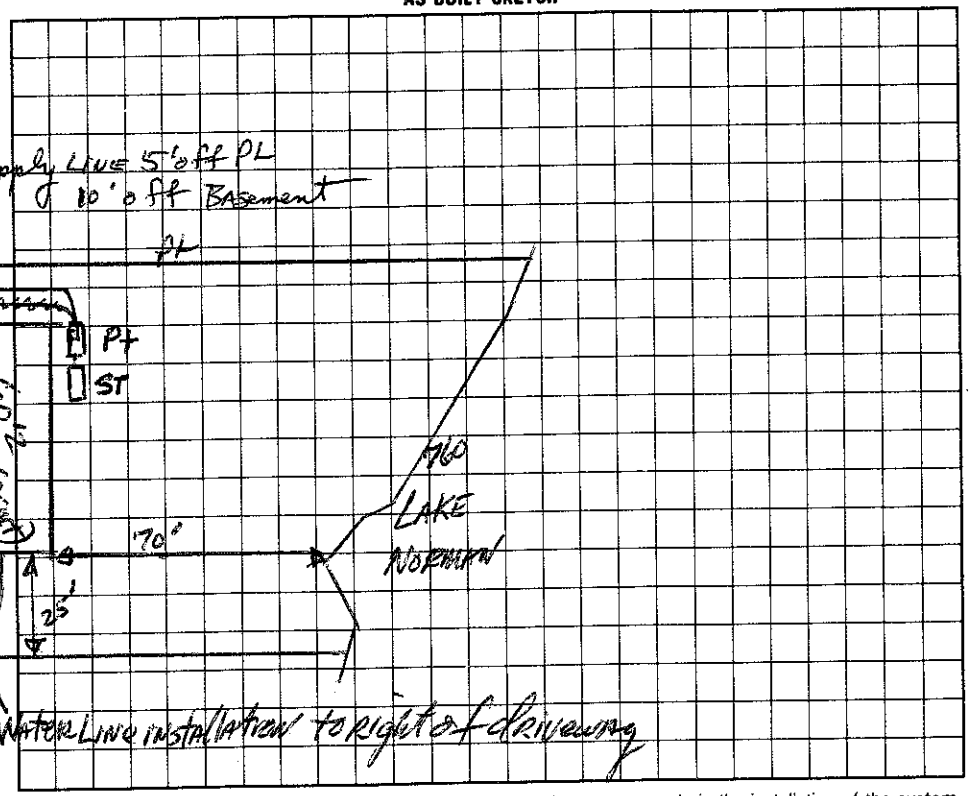

I understand that this permit can be suspended or revoked if any false information is supplied toward securing the permit/any unauthorized changes are made to the site/any unauthorized changes are made in the installation of the system.

RLW Wild IRIS LN.

Signed: _____

Improvement Permit by: _____, RS date 6-5-96

~~Final~~ System Inspection by: Wesley Sparks RS date 4/7/97

Installed by: Macleod Const. Co.

Certificate of Completion by: Wesley Sparks RS. date 11/7/97

Operation Permit by: Wesley Sparks RS. date 11/7/97

HEALTH DEPT. COPY: WHITE INSPECTION COPY (FINAL): GREEN OWNER COPY (FINAL): YELLOW INSPECTION COPY (INITIAL): PINK OWNER COPY (INITIAL): GOLD