IREDELL COUNTY HEALTH DEPARTMENT

Const. Auth. STATESVILLE 704-878-5305 MOORESVILLE 704-664-5281

IMPROVEMENT PERMIT / ~~CERTIFICATE OF COMPLETION~~ / OPERATION PERMIT / EXISTING SYSTEM INSPECTION

PROPERTY DESCRIPTION NO. 23358 DATE June 5, '96

OWNER OR CONTRACTOR Crescent Resources Attn: Bonnie Barbee PHONE: Business ~~part of 2643~~ 4620319070 Watershed: ☑ Yes ☐ No

ADDRESS PO Box 1003, Charlotte Home

LOCATION Brawley Sch Rd. TR Churchwood TL Morrow Ridge Ln TR Wild Iris at end

SUBDIVISION The Harbour BLOCK / SECTION III LOT 15 LOT AREA 20,000 ft² SITE CLASS. B pm.1956 DESIGN FLOW 480gpd L.T.A.R. e 3

Septic Tank: 1000 Gallons; STB 794 Date 12/9/98

Pump Tank: 1000 Gallons; PT 27 Date 12/16/98

Pump Make: HYDROMATIC Model SHEF 100A2 Serial No. 9098

Nitrification Field: No Fields 1 Square Feet 540 Linear Feet 270

No Lines 4 Trench Width 24" Max Trench Bottom Depth 30" Gravel Depth NA

☑ New System ☐ Repair System Type: I, II, III, (IV), V, VI

System Description: LP PPBPS

Repair System Description: LP PPBPS

Maintenance Agreement Required: ☑ Yes ☐ No

☑ House/Mod. Home No. Bedrooms 4

☐ Mobile Home No. Bathrooms 4

☐ Business No. Employees

☐ Other

☐ Slab ☑ Crawl Space ☑ Basement w/plumbing ☐ Basement wo/plumbing


Water Supply: ☐ Individual ☑ Community ☐ Public

Comments:


Comments: PARTIAL

1" = 50'

INITIAL SITE SKETCH

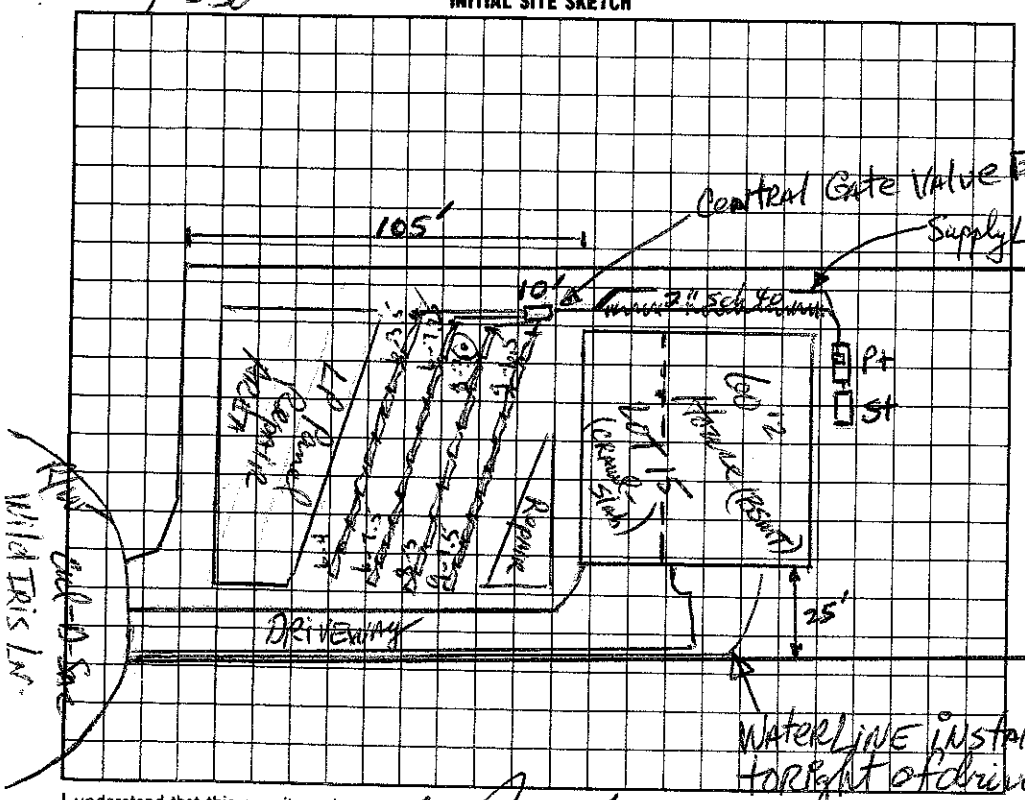

AS BUILT SKETCH

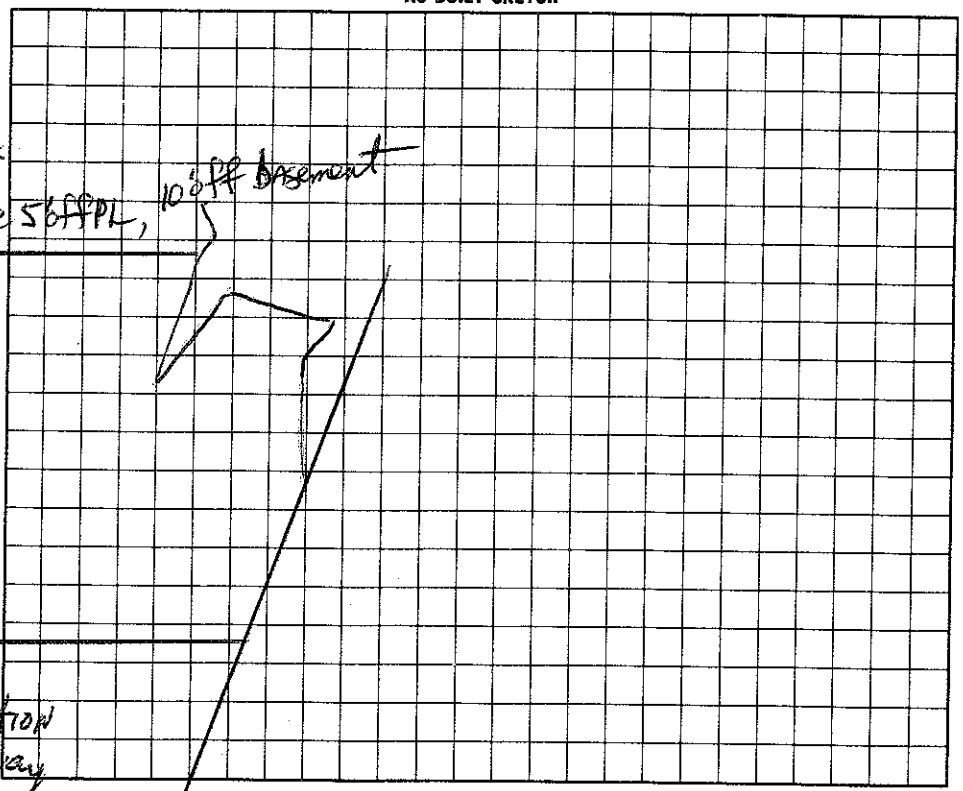

I understand that this permit can be suspended or revoked if any false information is supplied toward securing the permit/any unauthorized changes are made to the site/any unauthorized changes are made in the installation of the system.

Signed:

Improvement Permit by: Derek K. Hunger, LRS date 6-5-96

~~Existing System Inspection by:~~ Const. Auth. Wesley Sparks RS. date 6/29/98

Installed by: MacLeod Const.

Certificate of Completion by: date

Operation Permit by: Wesley Sparks RS. date 2/17/99

HEALTH DEPT. COPY: WHITE · INSPECTION COPY (FINAL): GREEN · OWNER COPY (FINAL): YELLOW · INSPECTION COPY (INITIAL): PINK · OWNER COPY (INITIAL): GOLD