IREDELL COUNTY HEALTH DEPARTMENT

$150

STATESVILLE 704-878-5305 MOORESVILLE 704-664-5281

IMPROVEMENT PERMIT / AUTHORIZATION TO CONSTRUCT / OPERATION PERMIT / EXISTING SYSTEM INSPECTION

PERMIT# 126488 PIN# 4626 32 0495

OWNER OR APPLICANT Mid-Atlantic Custom Bldr. PHONE: Business _____ Home _____

ADDRESS PO Box 3742 Mooresville NC 28117 DATE 11/3/05

LOCATION BSR TR Chuckwood TR Indian Trail

SUBDIVISION Waterfree Landing BLOCK / SECTION 2 LOT 18 LOT AREA 0.23Ac SITE CLASS PS DESIGN FLOW 480 L.T.A.R. 0.3

Septic Tank: 1000 Gallons; STB 1012 Date 6/15/05
Pump Tank: _____ Gallons; PT _____ Date _____
Pump Make: _____ Model _____ Serial No. _____
Nitrification Field: No Fields 1 Square Feet 1200 Linear Feet 400
No Lines 6@67' Trench Width 36" Max Trench Bottom Depth 36" Gravel Depth _____

☒ New System ☐ Repair ☐ Expansion System Type: I (II) III IV V VI
System Description: Gravity 25% Reduct.
Repair System Description: Pump Panel Block
Maintenance Agreement Required: ☐ Yes ☒ No
☒ Gravity ☐ Pressure

☒ House/Mod. Home ☐ Mobile Home ☐ Business ☐ Other
No. Bedrooms 4 No. Persons _____ No. Employees _____


Water Supply: ☒ Individual ☐ Public ☐ Community

☐ Slab ☒ Crawl Space ☐ Basement w/plumbing ☐ Basement wo/plumbing

Comments:/Conditions:


1"=50'

INITIAL SITE SKETCH

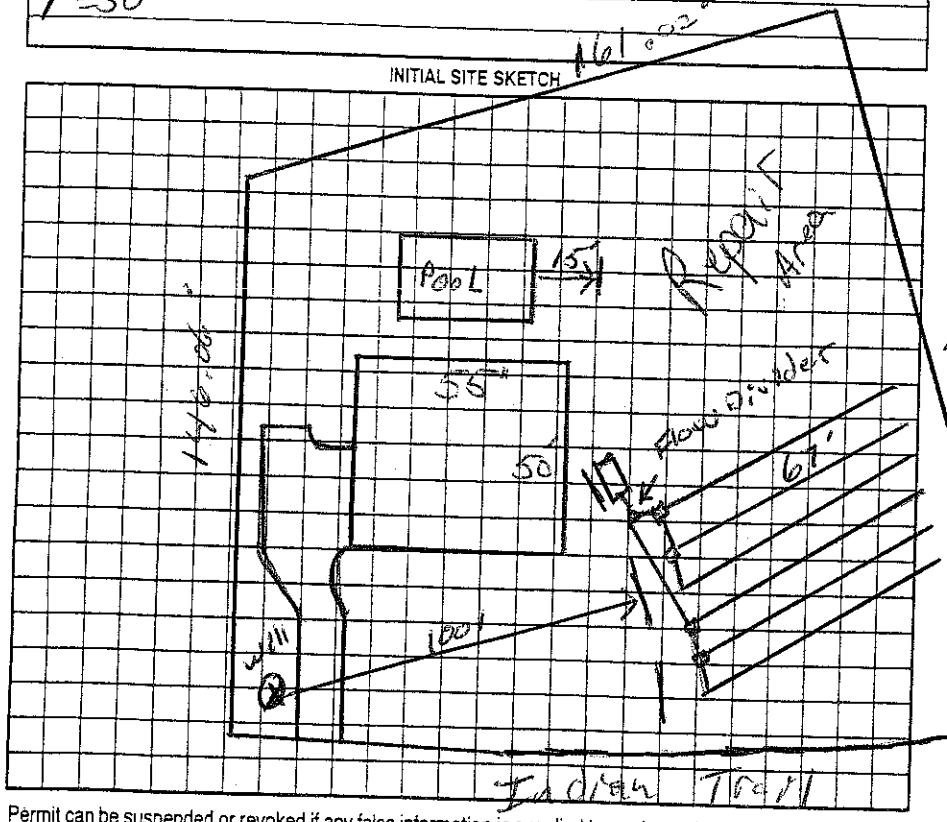

Comments:/Conditions: 57 V MARKER AND TUF-FIXP RIZXER INSTALLED W/ 100 QUICK-4 INFILTRATORS LINE LENGTHS CHANGED DUE TO UNEXPECTED WALL. WALL DRILLED IN LOCATION DRAWN

AS BUILT SKETCH

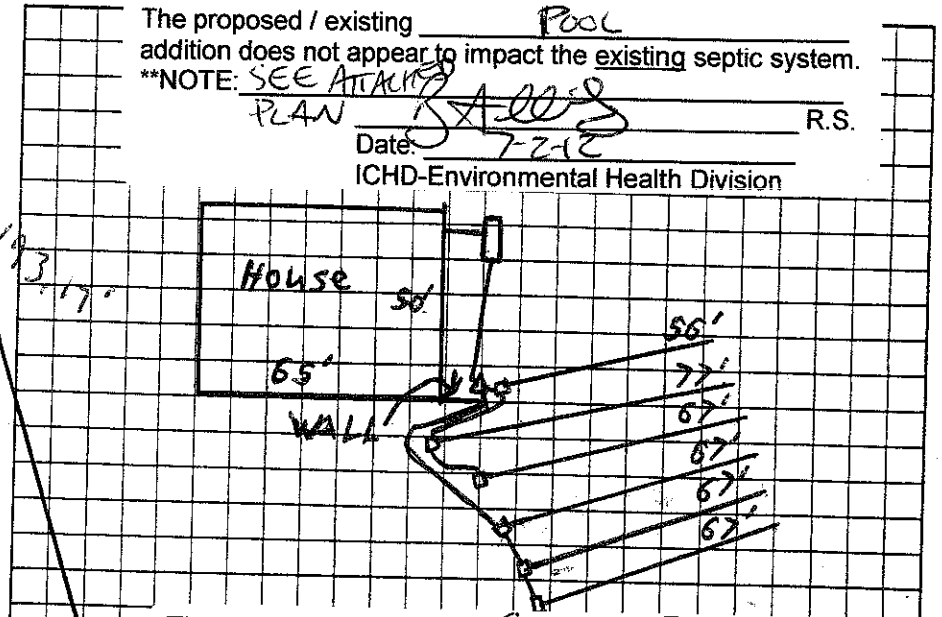

The proposed / existing Pool addition does not appear to impact the existing septic system.
**NOTE: SEE ATTACHED PLAN
R.S.
Date: 7-12-12
ICHD-Environmental Health Division

The proposed / existing Covered Patio addition does not appear to impact the existing septic system.
**NOTE:
R.S.
Date: 7-11-12
ICHD-Environmental Health Division

Permit can be suspended or revoked if any false information is supplied toward securing the permit/any unauthorized changes are made
Permit with plat valid without expiration ☑ Improvement Permit with site plan valid for sixty months ☑ Authorization to Co

Signed: Bill Sutton date 11-4-05 Installed by: Civil Grading & Trucking

Improvement Permit by: RS date 11/3/05 Operation Permit by: date 2/17/06

Authorization to Construct by: RS date 11/3/05 Existing System Inspection by: date

HEALTH DEPT. COPY: WHITE OWNER COPY (FINAL): YELLOW OWNER COPY (INITIAL): PINK