IREDELL COUNTY HEALTH DEPARTMENT

STATESVILLE 704-878-5305 MOORESVILLE 704-664-5281

IMPROVEMENT PERMIT / AUTHORIZATION TO CONSTRUCT / OPERATION PERMIT / EXISTING SYSTEM INSPECTION

PERMIT# 136796 PIN# 4626 32 1089 DATE 9/5/06

OWNER OR APPLICANT Scott Lee PHONE: Business 704-877-4272 Home

ADDRESS 601 Barber Loop Mooresville, NC. 28117

LOCATION 1100, TR Churchwood rd, .5 mile (R) Riviera (L) Pine Bluff Ln to last lot on (R)

SUBDIVISION Helms Harbor / SECTION LOT 113 LOT AREA .455 SITE CLASS. PS DESIGN FLOW 480 L.T.A.R. .3

Septic Tank: 1000 Gallons; STB 825 Date 6/03/07
Pump Tank: Gallons; PT Date
Pump Make: Model Serial No.
Nitrification Field: No Fields 1 Square Feet 1200 Linear Feet 400
No Lines 4 @ 100 Trench Width 3' Max Trench Bottom Depth 3'

☒ New System ☐ Repair ☐ Expansion System Type: I II (III) IV V VI
System Description: GRAV - 25% Reduction
Repair System Description: LP - 16" PPBRS
Maintenance Agreement Required: ☐ Yes ☒ No

☒ House/Mod. Home ☐ Mobile Home ☐ Business ☐ Other
No. Bedrooms 4 No. Persons No. Employees


Water Supply: ☒ Individual ☐ Public ☐ Community

Gravel Depth NA ☐ Gravity ☒ Pressure ☐ Slab ☒ Crawl Space ☐ Basement w/plumbing ☐ Basement wo/plumbing

Comments:/Conditions:

Comments:/Conditions:

1" = 40' INITIAL SITE SKETCH

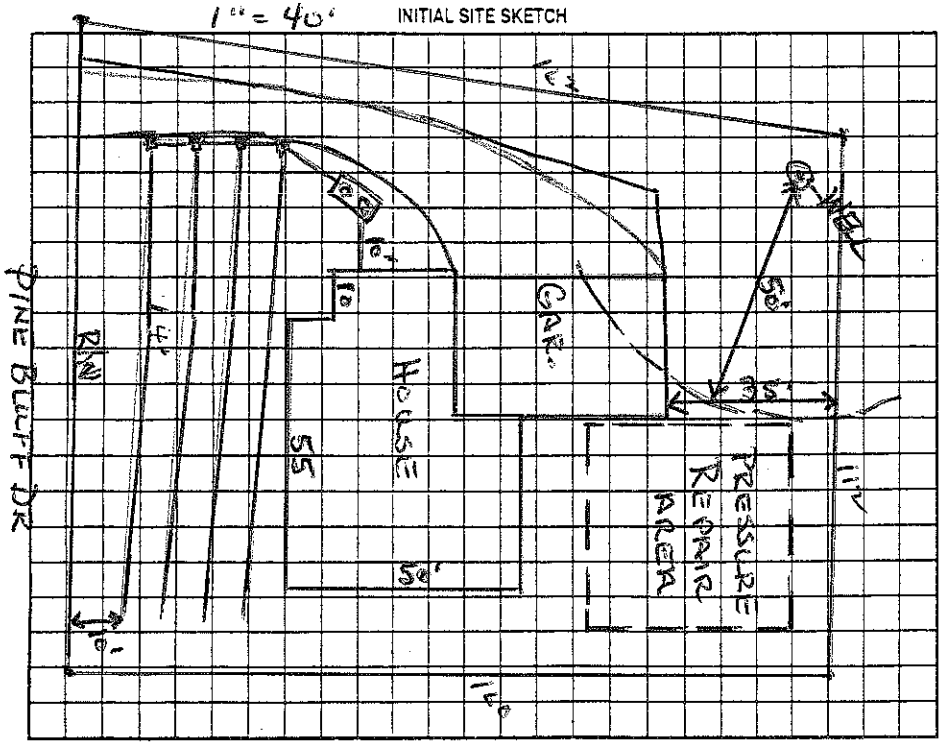

AS BUILT SKETCH

Permit can be suspended or revoked if any false information is supplied toward securing the permit/any unauthorized changes are made to the site/any unauthorized changes are made in the installation of the system. Improvement Permit with plat valid without expiration ☐ Improvement Permit with site plan valid for sixty months ☐ Authorization to Construct is valid for a period equal to that of Improvement Permit – not to exceed sixty months.

Signed: [signature] date 9/7/06 Installed by: Rowan Septic Tank

Improvement Permit by: Wesley Sparks RS date 9/6/06 Operation Permit by: Wesley Sparks RS date 7/19/07

Authorization to Construct by: Wesley Sparks RS. date 9/6/06 Existing System Inspection by: date

HEALTH DEPT. COPY: WHITE OWNER COPY (FINAL): YELLOW OWNER COPY (INITIAL): PINK