IREDELL COUNTY HEALTH DEPARTMENT

STATESVILLE 704-878-5305 MOORESVILLE 704-664-5281

IMPROVEMENT PERMIT / AUTHORIZATION TO CONSTRUCT / OPERATION PERMIT / EXISTING SYSTEM INSPECTION

PERMIT# 126490 PIN# 4626322825 Bill Bethune DATE 9-15-05

OWNER OR CONTRACTOR Mid Atlantic Custom Builders PHONE: Business 980 722-0230 Home

ADDRESS P.O. Box 3792 Mooresville NC 28117

LOCATION Brawley School Rd TR Chuckwood TR Indian Trail Lot on right

SUBDIVISION Waterfree Land BLOCK / SECTION 2 LOT 20 LOT AREA .68 Acre SITE CLASS PS DESIGN FLOW 480 gpd L.T.A.R. .25 to .3

Septic Tank: 1000 Gallons; STB 794 Date 2/15/06

Pump Tank: 1000 Gallons; PT 253 Date 3-12-06

Pump Make: Gaulds Model PE41M Serial No.

Nitrification Field: No Fields 1 Square Feet 1440 Linear Feet 480

No Lines 4@120' Trench Width 36" Max Trench Bottom Depth 18"

☒ New System ☐ Repair System Type: I, II, III, IV, V, VI

System Description: Pump-PM-25% Reduction

Repair System Description: Pump-LP-Panel Block

Maintenance Agreement Required: ☐ Yes ☒ No Not initially

Gravel Depth N/A

☒ House/Mod. Home No. Bedrooms 4

☐ Mobile Home No. Bathrooms

☐ Business No. Employees

☐ Other


☐ Slab ☐ Crawl Space ☐ Basement w/plumbing ☐ Basement wo/plumbing

Water Supply: ☐ Individual ☐ Public ☐ Community

Comments/Conditions: *Note: Must keep Septic System shallow to stay out of Saprolite & ≥ 100ft to well.

Comments/Conditions: Must keep DrainField out of Saprolite otherwise 100ft setback to well will be required. *Do not cut for house pad, backfill against house

INITIAL SITE SKETCH Scale 1:50

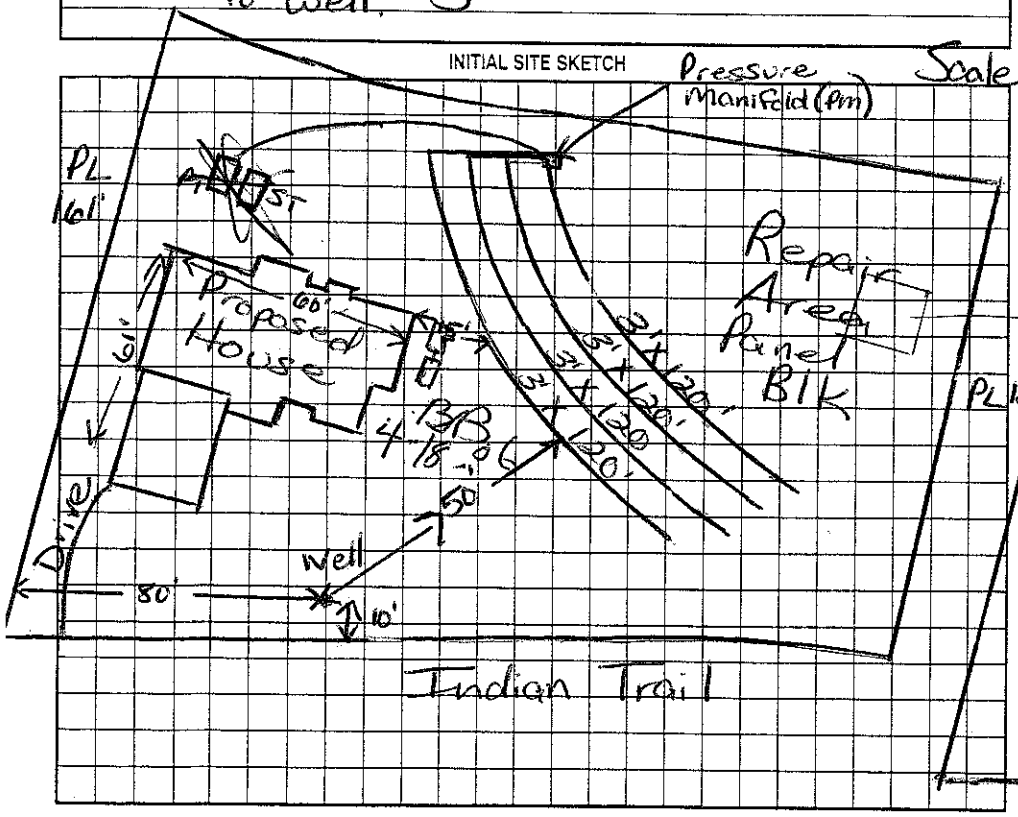


AS BUILT SKETCH

Checked 2 lines 4/13/06 Quick 4
Checked rest of lines 4/17/06 GM
Pres, elect & alarm MK

(As built)

A.C. 3/27/09

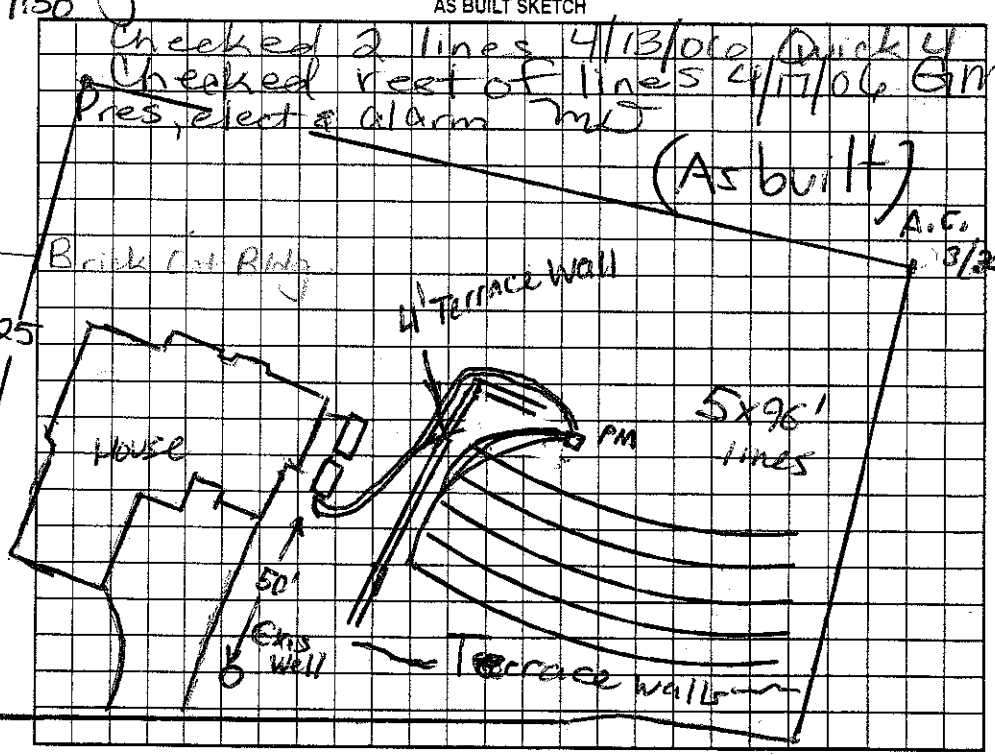

Permit can be suspended or revoked if any false information is supplied toward securing the permit/any unauthorized changes are made to the site/any unauthorized changes are made in the installation of the system. Improvement Permit with plat valid without expiration. Improvement Permit with site plan valid for sixty months. Authorization to Construct is valid for a period equal to that of Improvement Permit – not to exceed sixty months.

Signed: George Bethune date 9-20-05 Installed by: Howard Brothers

Improvement Permit by: Maria H. Dolson RS date 9/15/05 Operation Permit by: Maria H. Dolson RS date 4/18/06

Authorization to Construct by: Maria H. Dolson RS date 9/15/05 Existing System Inspection by: date

HEALTH DEPT. COPY: WHITE OWNER COPY (FINAL): YELLOW OWNER COPY (INITIAL): PINK