# IREDELL COUNTY HEALTH DEPARTMENT

STATESVILLE 704-878-5305 350.00 Paid MOORESVILLE 704-664-5281 11:30

**IMPROVEMENT PERMIT / AUTHORIZATION TO CONSTRUCT / OPERATION PERMIT / EXISTING SYSTEM INSPECTION**

PERMIT# 126495 PIN# 4626 32 3380

OWNER OR APPLICANT Mid Atlantic Custom Builders PHONE: Business ______ Home ______ DATE 1/13/06

ADDRESS PO Box 3792 Mooresville, NC 28117

LOCATION Brawley School Rd Ⓛ Chuckwood Ⓛ Indian Trail Ⓡ Lot 370 Indian Trail

SUBDIVISION Water Tree Landing BLOCK / SECTION 2 LOT 25 LOT AREA .69 Acres SITE CLASS. PS DESIGN FLOW 480 gpd L.T.A.R. .3

Septic Tank: 1000 Gallons; STB 794 Date 4-11-06
Pump Tank: ______ Gallons; PT ______ Date ______
Pump Make: ______ Model ______ Serial No. ______
Nitrification Field: No Fields 1 Square Feet eq 1600 Linear Feet 400
No Lines ~~6~~ 7 Trench Width 36" Max Trench Bottom Depth 24" Gravel Depth NA ☒ Gravity ☐ Pressure

☒ New System ☐ Repair ☐ Expansion System Type: I (II) III IV V VI
System Description: 25% Reduction
Repair System Description: LP PPBPS
Maintenance Agreement Required: ☐ Yes ☒ No

☒ House/Mod. Home ☐ Mobile Home ☐ Business ☐ Other ______
No. Bedrooms 4 No. Persons ______ No. Employees ______


Water Supply: ☒ Individual ☐ Public ☐ Community

☐ Slab ☒ Crawl Space ☐ Basement w/plumbing ☐ Basement wo/plumbing

Comments:/Conditions: Install on contour. Maintain setbacks. Abandon old well on Lot 24.
Scale: 1" = 50'

Comments:/Conditions: Installed 6 lines @ 60 ft & 1-line @ 40' = 400' Quick 4
Checked tanks & lines 5/26/06 MT

INITIAL SITE SKETCH

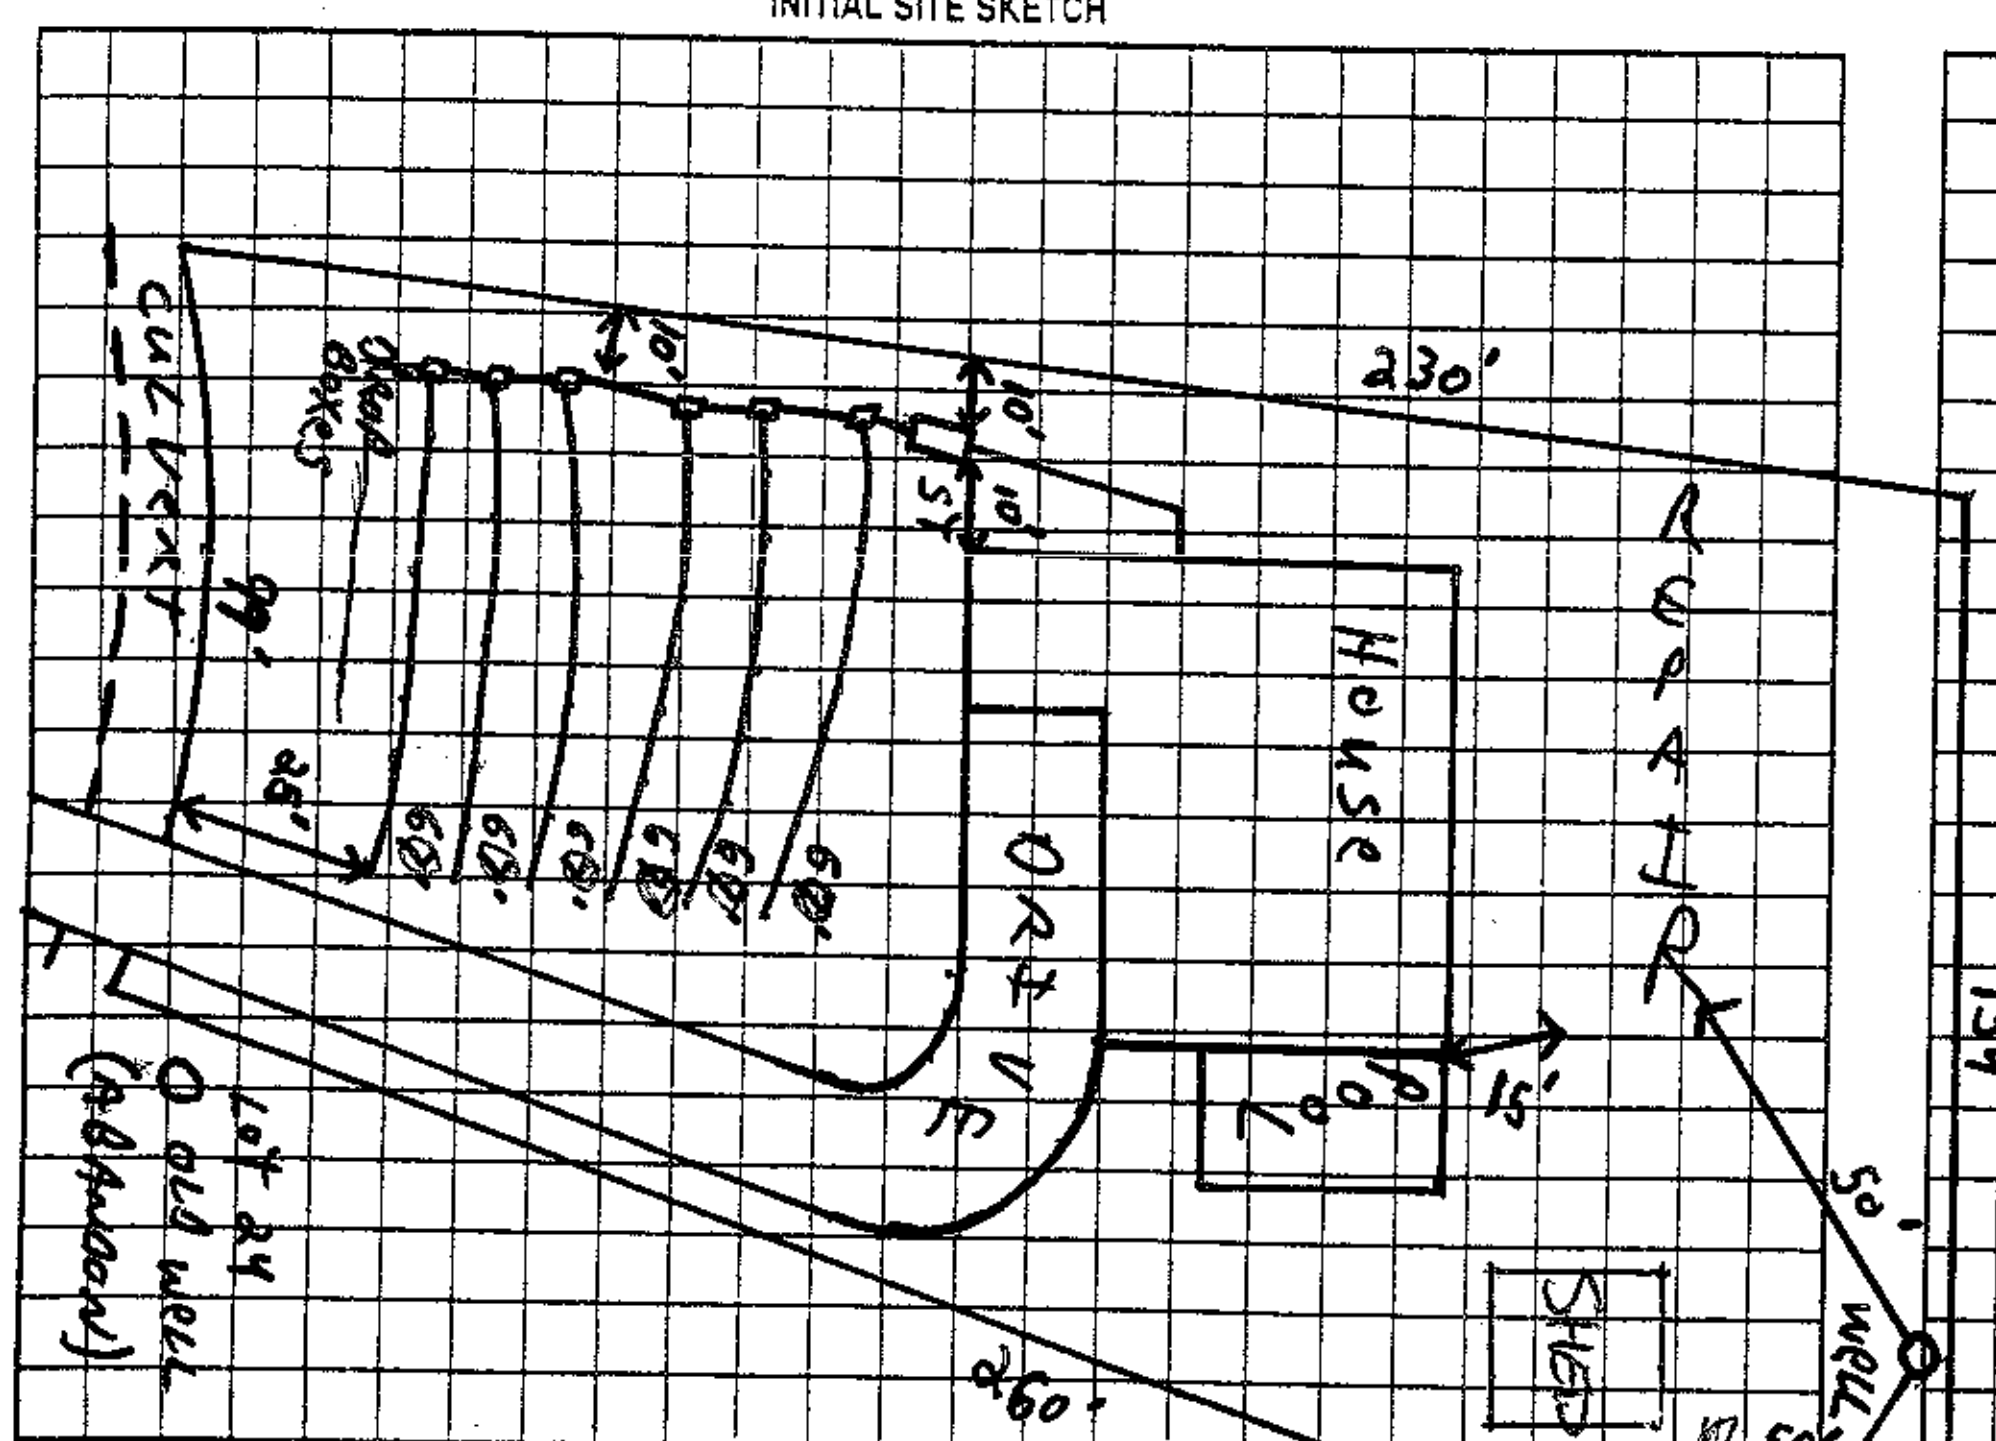


AS BUILT SKETCH

The proposed Shed addition does not appear to impact the existing septic system.
**NOTE: ______

[signature] R.S.
Date: 12-1-08
ICHD-Environmental Health Division

* Shed sitting on blocks (No Foundation)

Permit can be suspended or revoked if any false information is supplied toward securing the permit/any unauthorized changes are made to the site/any unauthorized changes are made in the installation of the system. Improvement Permit with plat valid without expiration ☐ Improvement Permit with site plan valid for sixty months ☒ Authorization to Construct is valid for a period equal to that of Improvement Permit – not to exceed sixty months.

Signed: [signature] date 1-13-06
Improvement Permit by: [signature] date 1/13/06
Authorization to Construct by: [signature] date 1/13/06

Lot 24 Repair Area

Installed by: Howard Brothers
Operation Permit by: [signature] date 5/31/06
Existing System Inspection by: ______ date ______

HEALTH DEPT. COPY: WHITE OWNER COPY (FINAL): YELLOW OWNER COPY (INITIAL): PINK