IREDELL COUNTY HEALTH DEPARTMENT

STATESVILLE 704-878-5305 MOORESVILLE 704-664-5281

IMPROVEMENT PERMIT / AUTHORIZATION TO CONSTRUCT / OPERATION PERMIT / EXISTING SYSTEM INSPECTION

PERMIT# 2196 PIN# 2FIA 20C 4626 32 4655 CL&T 5-7 Lot 20C DATE 9/14/98

OWNER OR CONTRACTOR JENNIFER SEBOLE PHONE: Business Home

ADDRESS PO BOX 1003 CHARLOTTE - (CL&T)

LOCATION BRAWLEY SCHOOL - TR CHUCKWOOL - TR INDIAN TRAIL - NEAR END ON LT

SUBDIVISION CL&T BLOCK / SECTION VII LOT 1676 LOT AREA 1.44AC SITE CLASS. RS DESIGN FLOW 360 L.T.A.R. .3

Septic Tank: 1000 Gallons; STB 794 Date 5/29/98

Pump Tank: 1000 Gallons; PT 27 Date 7/7/98

Pump Make: SK50A1 Model HYDROMATIC Serial No. 2198

Nitrification Field: No Fields 1 Square Feet 900 Linear Feet 306

No Lines 5 @ 60' Trench Width 36" Max Trench Bottom Depth 30" Gravel Depth N/A

☑ New System ☐ Repair System Type: I, II, (III), IV, V, VI

System Description: PUMP CHAMBERS OR HD

Repair System Description: PANEL

Maintenance Agreement Required: ☐ Yes ☑ No

☑ House/Mod. Home No. Bedrooms 3

☐ Mobile Home No. Bathrooms 3

☐ Business No. Employees

☐ Other

☐ Slab ☐ Crawl Space ☑ Basement w/plumbing ☐ Basement wo/plumbing


Water Supply: ☑ Individual ☐ Public ☐ Community

Comments:/Conditions:


Comments:/Conditions:

1"=60'

INITIAL SITE SKETCH

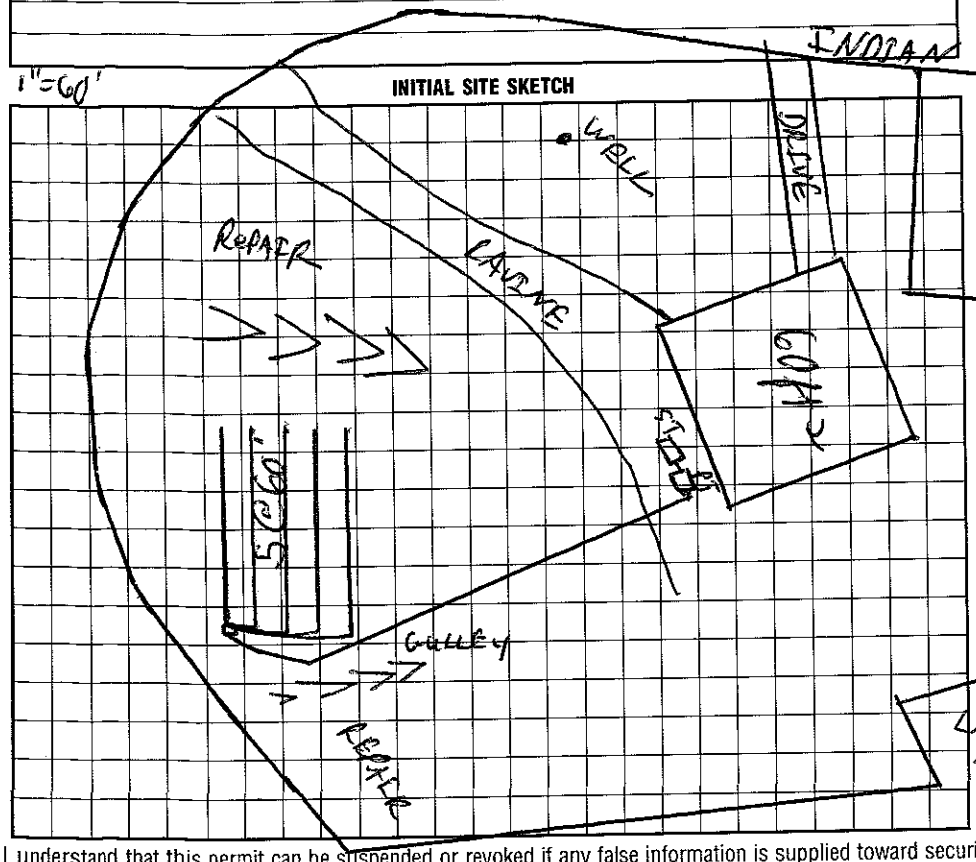

AS BUILT SKETCH

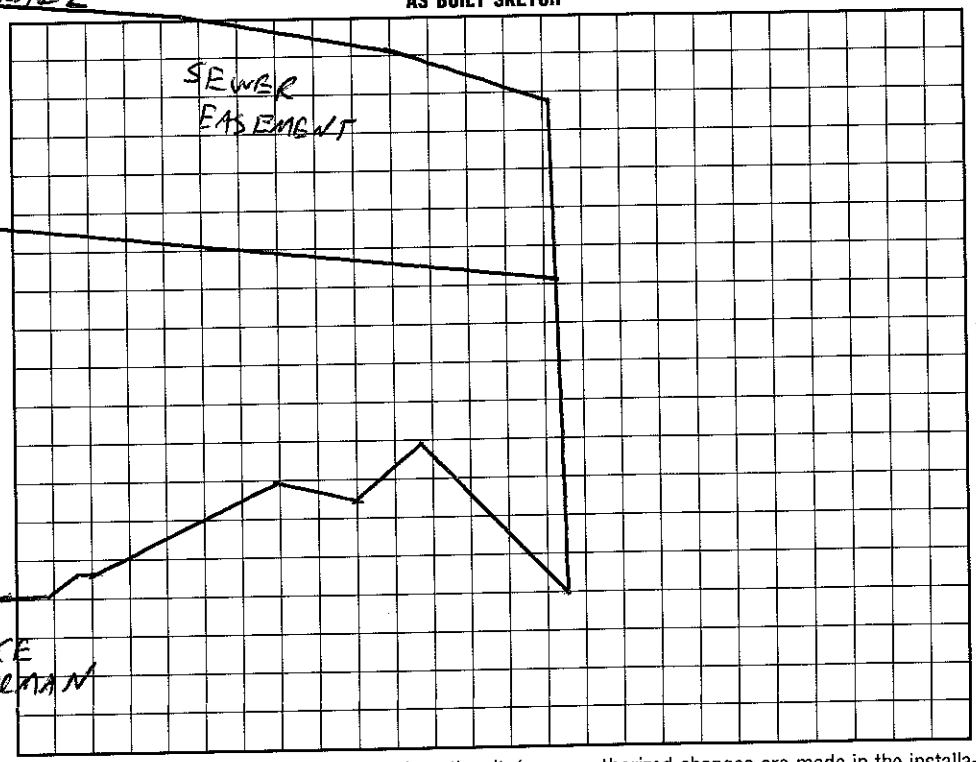

I understand that this permit can be suspended or revoked if any false information is supplied toward securing the permit/any unauthorized changes are made to the site/any unauthorized changes are made in the installation of the system. Improvement Permit with plat valid without expiration. Improvement Permit with site plan valid for sixty months. Authorization to Construct is valid for a period equal to that of Improvement Permit – not to exceed sixty months.

Signed: Ricky King 9-17-98 date

Permit by: [signature] RS date 9/14/98

by: [signature] RS date 9/14/98

Installed by: Dent Dunnagan

Operation Permit by: Wesley Sparks RS. date 12/1/98

Existing System Inspection by: date

WHITE INSPECTION COPY (FINAL): GREEN OWNER COPY (FINAL): YELLOW INSPECTION COPY (INITIAL): PINK OWNER COPY (INITIAL): GOLD