IREDELL COUNTY HEALTH DEPARTMENT

STATESVILLE 704-878-5305 — MOORESVILLE 704-664-5281

IMPROVEMENT PERMIT / AUTHORIZATION TO CONSTRUCT / OPERATION PERMIT / EXISTING SYSTEM INSPECTION

PERMIT# 126497 PIN# 4626326312 DATE 9-15-05

OWNER OR CONTRACTOR Mid-Atlantic Custom Blds PHONE: Business 704-202-5568 Ray Home 980-722-0230 Bill

ADDRESS P.O. Box 3792 Mooresville 28117

LOCATION Brawley School Rd. TR Chuckwood TR Indian Trail on right

SUBDIVISION Water+Tee Landing BLOCK / SECTION ____ LOT 27 LOT AREA .77 SITE CLASS PS DESIGN FLOW 480 L.T.A.R. .25

Septic Tank: 1000 Gallons; STB 1012 Date 6-11-05

Pump Tank: ____ Gallons; PT ____ Date ____

Pump Make: ____ Model ____ Serial No. ____

Nitrification Field: No Fields 1 Square Feet ____ Linear Feet 480

No Lines 6 @ 80' Trench Width 36" Max Trench Bottom Depth 36" Gravel Depth NA

☒ New System ☐ Repair System Type: I, II, III, IV, V, VI

System Description: 25% reduction, gravity

Repair System Description: LP Panel

Maintenance Agreement Required: ☐ Yes ☒ No

☒ House/Mod. Home No. Bedrooms 4

☐ Mobile Home No. Bathrooms ____

☐ Business No. Employees ____

☐ Other ____

☐ Slab ☒ Crawl Space ☐ Basement w/plumbing ☐ Basement wo/plumbing

Water Supply: ☒ Individual ☐ Public ☐ Community

Comments:/Conditions:


Comments:/Conditions:

Installed standard infiltrator chamber 500' - 8 lines - lengths listed below Yellow tuf tite filter. Septic tank w/marker Installed as follows: Septic tank installed in front of garage with 8 lines instead of 6. Drop boxes 20' from PL instead of 10'


Line lengths from Rd.: 69', 64', 67', 60', 57', 63', 53', 68', 53', 69', 53', 62', 157', 85', 118', 48', 2', 18', ~~570'~~ 490'

1" = 50'

INITIAL SITE SKETCH

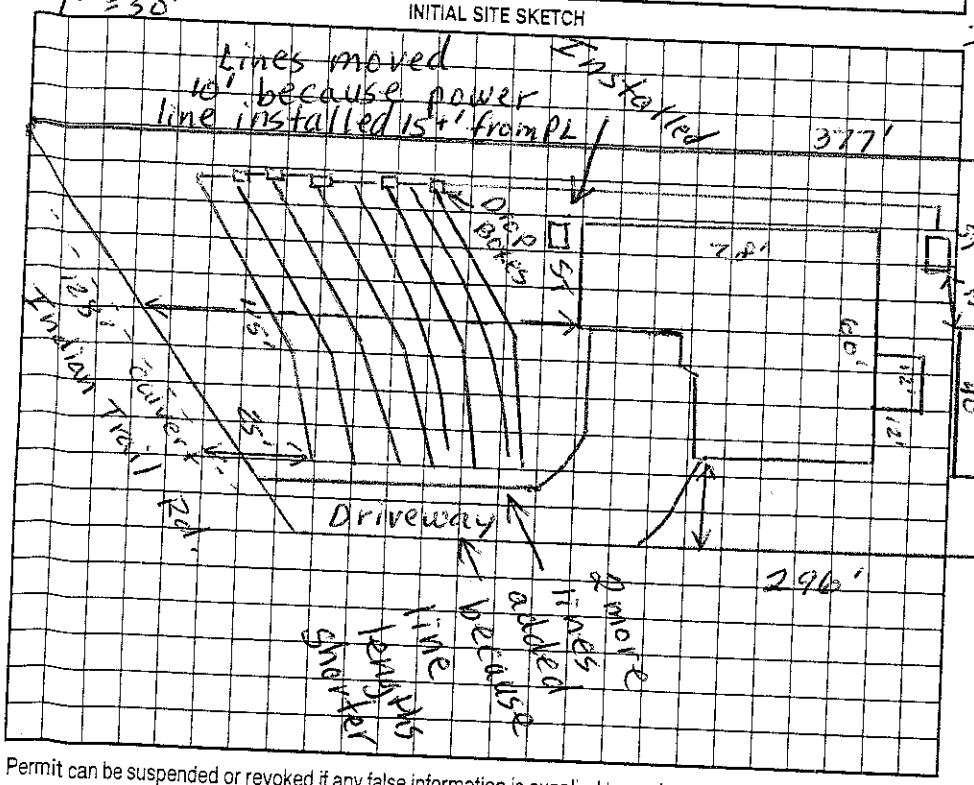

AS BUILT SKETCH

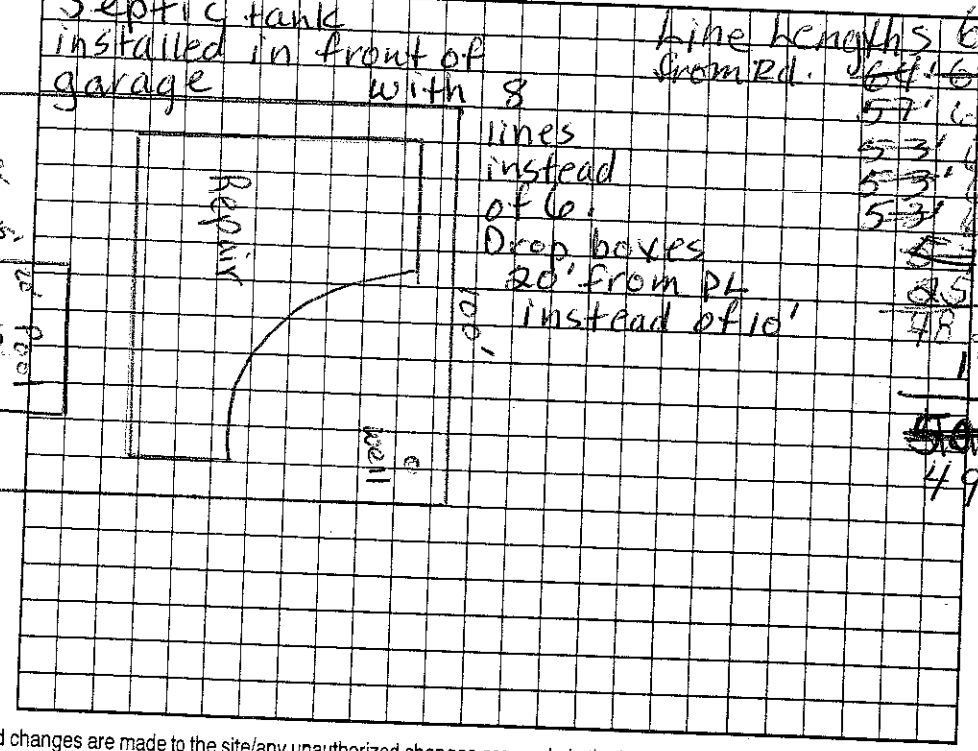

Permit can be suspended or revoked if any false information is supplied toward securing the permit/any unauthorized changes are made to the site/any unauthorized changes are made in the installation of the system. Improvement Permit with plat valid without expiration. Improvement Permit with site plan valid for sixty months. Authorization to Construct is valid for a period equal to that of Improvement Permit – not to exceed sixty months.

Signed: Bill Bethune date 9-16-04

Improvement Permit by: Judy Melville date 9-15-05

Authorization to Construct by: Judy Melville date 9-15-05

Installed by: Craig Thompson

Operation Permit by: Judy Melville date 2-1-06

Existing System Inspection by: ____ date ____

HEALTH DEPT. COPY: WHITE OWNER COPY (FINAL): YELLOW OWNER COPY (INITIAL): PINK