ICHD–ENVIRONMENTAL HEALTH DIVISION

KW

Statesville Office (704) 878-5305 | Mooresville Office (704) 660-3625

PERMIT # AP-306355

SEPTIC IMPROVEMENT PERMIT / AUTHORIZATION TO CONSTRUCT / OPERATION PERMIT / EXISTING SYSTEM

PIN # 4626-33-0241

APPLICANT/OWNER: Nanette M. Stuckey | APPLICANT ADDRESS: 293 Indian Trail Mooresville, NC

SITE ADDRESS: 293 Indian Trail Mooresville | PHONE: 704-578-4648 | ALT. PHONE: —

SITE DIRECTIONS: BSR → Chuckwood → Indian Trail → House on left. | SAP CONTROLLED: ☐ YES ☒ NO

SUBDIVISION: CL+T | SECTION: 7 | LOT # 30 | LOT AREA: 0.7 | DESIGN FLOW: 360 GPD | L.T.A.R.: —


Septic Tank	1000 (gal)	STB 760	Date 1/27	☐ New System	☒ Repair	☐ Expansion	System Type: I II III IV V VI
Pump Tank	— (gal)	PT —	Date —	System Description:	Replace Septic tank. Pump+		
Pump Make	—	Model —	Serial # —	Repair System Description:	crush old tank		
# Nitrification Fields	—	# Lines	Lineal Ft	Maintenance Agreement Required:	☐ YES	☒ NO	
Trench Width	EXISTING	Trench Bottom Depth(Low side)		Gravel Depth —	☒ GRAVITY	☐ PRESSURE	

☒ Residence — No. Bedrooms 3
☐ Business — No. Persons 6
☐ Other — No. Employees
☐ Slab — ☒ Crawl Space
☐ Basement w/plumbing — ☐ Basement w/o plumbing


Water Supply: ☒ Private ☐ Public ☐ Community

Comments / Conditions: Recommend replace D-Box if needed. House sewer line may need to be re-worked to ensure replacement tank meets code.

INITIAL SITE SKETCH

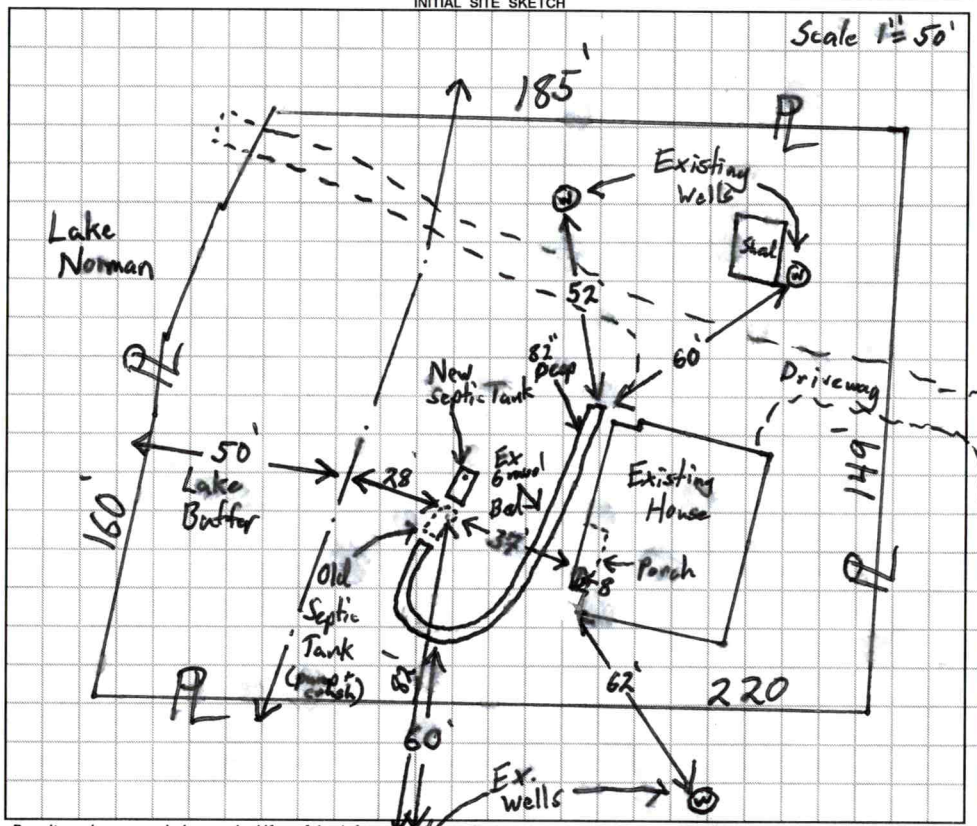

AS BUILT SKETCH

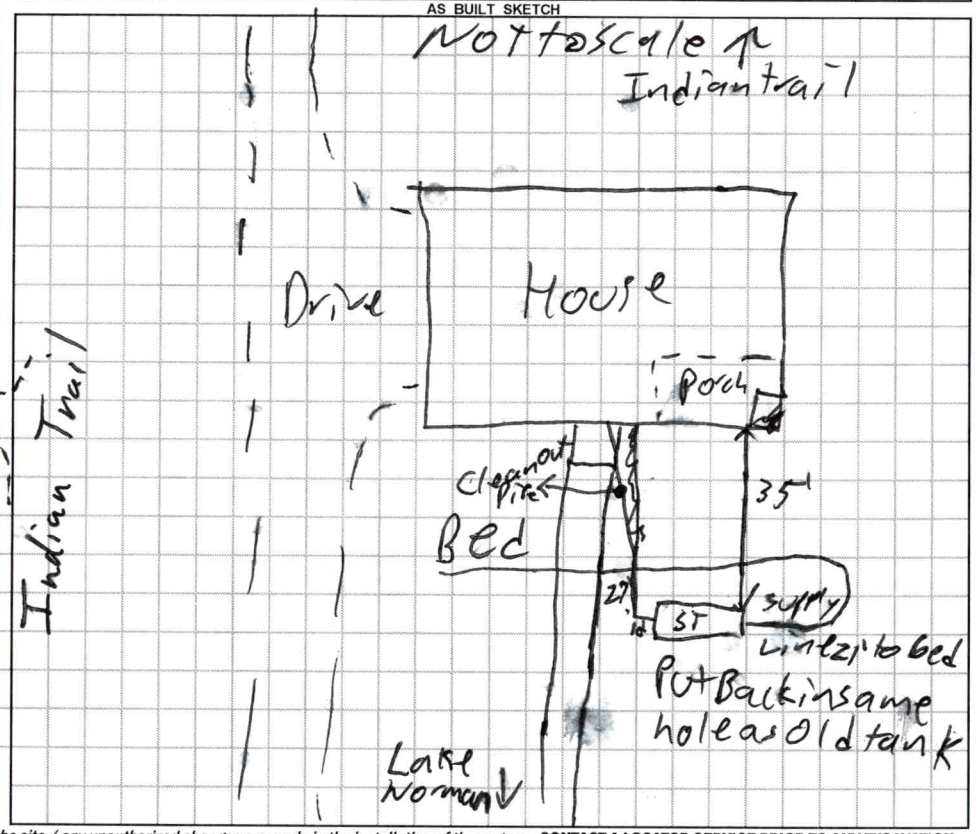

Permit can be suspended or revoked if any false information is supplied toward securing the permit / any unauthorized changes are made to the site / any unauthorized changes are made in the installation of the system. **CONTACT A LOCATOR SERVICE PRIOR TO ANY EXCAVATION**

☐ **IMPROVEMENT PERMIT** *with plat valid without expiration..* ☒ **IMPROVEMENT PERMIT** *with site plan valid for 60 mos.* ☒ **AUTHORIZATION TO CONSTRUCT** *valid for period equal to IMPROVEMENT PERMIT--not to exceed 60 mo.*

Owner / Applicant Signature: Acceptance of Permit Recvd | Date: 3.31.2020 | Installed by: Lentz Wastewater

IMPROVEMENT PERMIT by: Sam Shuck | Date: 3/30/2020 | OPERATION PERMIT by: Patrick J Bagley III | Date: 3/31/2020

AUTHORIZATION TO CONSTRUCT by: Sam Shuck | Date: 3/30/2020 | Existing System Inspected by: | Date:

FOR SEPTIC FINAL INSPECTION: CALL 704-664-3703 between 8am-9am the day the inspection is needed. Be sure to speak with an inpsector to confirm your inspection time.

IREDELL COUNTY HEALTH DEPARTMENT
JANE HINSON, RN BSN MS
HEALTH DIRECTOR

Public Health
Prevent. Promote. Protect.
Iredell County Health Department

ACKNOWLEDGEMENT OF ACCEPTANCE OF PERMIT DESIGN AND CONDITIONS

Any permit requiring a signature must have this form signed by the property owner or their authorized agent. Once this form is signed and returned to Environmental Health an official copy of the permit will be emailed to the email that you provide.

I, Nanette M. Stuckey, am the legal owner or the agent of the property located at 213 Indian Trail Mooresville NC 28117, identified as PIN(Parcel Identification Number) 4726-33-0241, located in Iredell County, North Carolina.
Permit # AP-306355.

I do hereby agree to the permit design and the conditions of this permit.

Nanette M. Stuckey March 30 2020
Signature of Owner/Authorized Agent Date

_____ _____
Signature of Witness Date

nstuckey@aol.com
email

* CAN'T FLUSH - BACKING UP IN HOUSE - RECEIVED MAR 2 6 2020

Jake Williams Excavating 0719

IREDELL COUNTY DEPARTMENT of ENVIRONMENTAL HEALTH

APPLICATION FORM

AP-306355

Application For: ( ) New Well Permit ( ) Well Repair Permit ( ) Well Abandonment
( ) Septic Improvement Permit ( ) Authorization to Construct ( ) Existing System Inspection (X) Septic System Repair

THE ABOVE PERMIT DOCUMENTS WILL BECOME INVALID IF INFORMATION PROVIDED ON THIS APPLICATION IS FALSIFIED OR CHANGED, OR IF THE SITE IS ALTERED. THE IMPROVEMENT PERMIT IS VALID FOR EITHER 60 MONTHS OR WITHOUT EXPIRATION DEPENDING UPON DOCUMENTATION SUBMITTED. APPLICATION WITH SITE PLAN 60 MONTHS, APPLICATION WITH COMPLETE, SCALED PLAT WITHOUT EXPIRATION. SEE 15A NCAC 18A .1937(f) FOR DETAILS.

Page 2: *Site Plan Worksheet* form MUST accompany this application Repair Evaluation

The following optional attachments may also be submitted: ( ) Survey Plat, scaled no more than 1 inch = 60 feet
Place an (X) beside whichever is submitted if applicable ( ) Custom Site Plan, scaled no more than 1 inch = 60 feet

Applicant Information: (PRINT CLEARLY)

Applicant Name: Nanette M. Stuckey Address: 293 Indian Trail Zip: 28117
Applicant Email: nstuckey@aol.com Phone: 704-578-4648 Alt. Phone:
Owner Name: Nanette M. Stuckey Address: 293 Indian Trail Zip: 28117
Owner Email: nstuckey@aol.com Phone: 704-578-4648 Alt. Phone:

Property Information:

Street Address: 293 Indian Trail Mooresville, NC 28117

Subdivision Name: Section/Phase: Lot Number:

Driving Directions: Brawley School Rd. to Chuckerwood to Indian Trail - House on left about a mile

Site Development Information: *(check or complete ALL that apply*

CHECK FOUNDATION TYPE

( ) New Single Family Residence Maximum Number of Bedrooms: ( ) Crawl Space Foundation
( ) New Multi-Family Residence Maximum Number of Occupants: ( ) Concrete Slab Foundation
( ) Accessory Building ( ) Swimming Pool ( ) Basement with Plumbing
( ) Bedroom(s) Addition ( ) Other Addition/Structure: ( ) Basement without Plumbing
(X) Repair to failing septic system X Tank ___ Drain lines Describe Problem: muddy water in tank, roots in mid seams
Non-Residential Site Development: Type of Business:
Square Footage of Building: Max. Number of Employees: Max. Number of Seats/Beds/Other:

Water Supply: ( ) Replacement Well – Reason:
( ) Multi-connection Well Number of Houses: Number of Persons:
( ) New Well (X) Existing Well ( ) Community Well ( ) City Water ( ) Other Public Water

Desired Septic System Type: *(you may rank in order of preference)* Year existing system installed:
( ) No Preference ( ) Alternative ( ) Conventional ( ) Innovative ( ) Modified Conventional ( ) Other:

Please answer the following to the best of your ability:
( ) Yes (X) No Does the site contain any jurisdictional wetlands?
( ) Yes (X) No Is any non-domestic sewage (i.e. industrial) to be generated?
( ) Yes (X) No Is the site subject to approval by any other public agency?

I have read this application and certify that the information provided herein is true, complete, and correct. Authorized county and state officials are granted right of entry to conduct necessary inspections to determine compliance with applicable laws and rules. I understand that I am solely responsible for the proper identification and labeling of all property lines and corners and making the site accessible so that a complete site evaluation can be performed.

Signature: Nanette M. Stuckey March 26, 2020
Property owner or owner's legal representative signature (SIGNATURE REQUIRED) DATE


IREDELL COUNTY DEPARTMENT of ENVIRONMENTAL HEALTH

SITE PLAN WORKSHEET

SEE THE "SAMPLE SITE PLAN" BELOW. *INCOMPLETE SITE PLANS WILL BE RETURNED TO YOU FOR COMPLETION AND MAY RESULT IN A DELAY IN THE ISSUANCE OF YOUR SEPTIC SYSTEM OR WELL PERMIT!!!*

Place an (X) beside each item as you complete the site plan:

- ( ) **Property Line measurements are clearly identified**
- ( ) **All proposed structures are indicated**
- ( ) **Front and side setbacks from property line**
- ( ) **Preferred driveway location**
- ( ) **Preferred well location**
- ( ) **Preferred septic system location**
- ( ) **North arrow, or other sufficient indicator of direction**

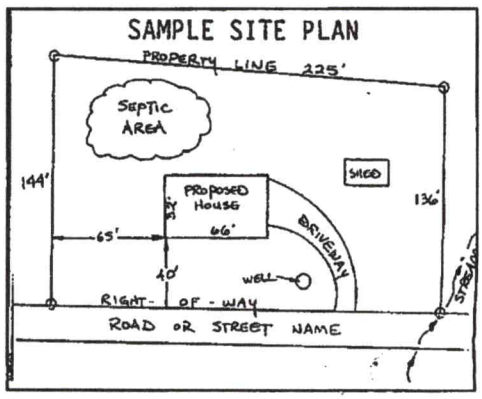


Circle N/A on the following if appropriate:

Location of septic systems and wells within 100' of your property	**N/A**
Location of easements and rights of ways on your property	**N/A**
Location of any designated wetlands on the property	**N/A**

USE THIS SPACE TO DRAW YOUR SITE PLAN

Show: proposed house or business footprint, wells, water lines, patios, pools and decks, and any other item that will occupy space on the site

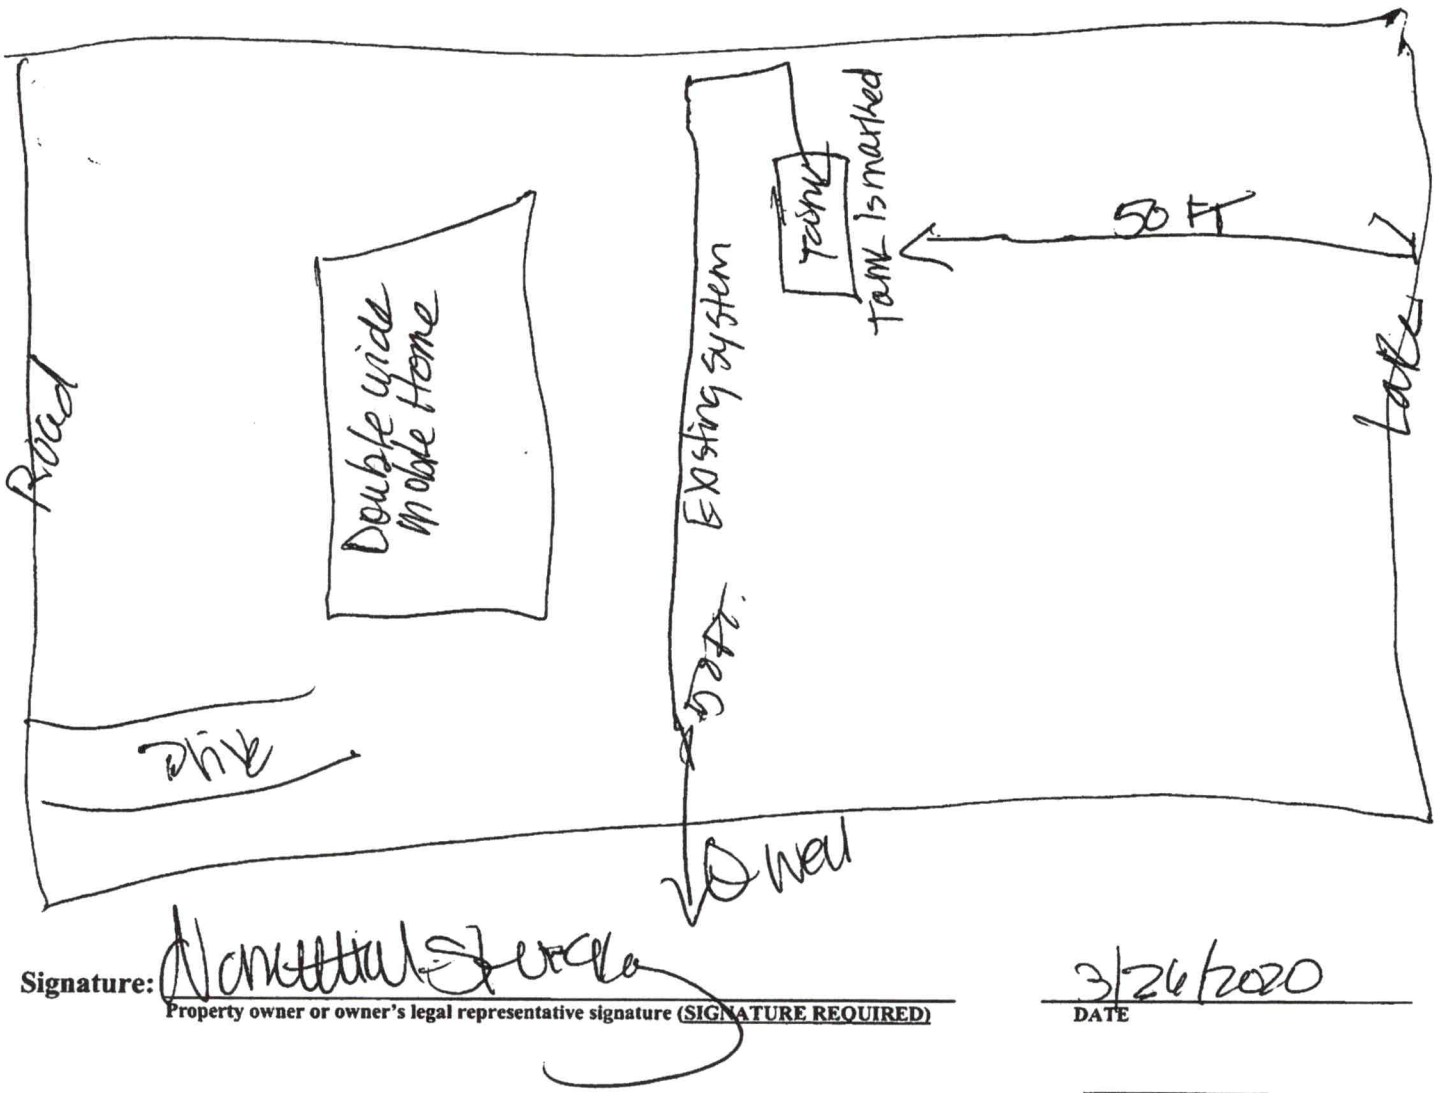

Signature: _____
Property owner or owner's legal representative signature (SIGNATURE REQUIRED)

3/26/2020
DATE

DOCUMENTATION TO AUTHORIZE AN OWNER'S LEGAL REPRESENTATIVE

Applications for permits require the "signature of the owner or owner's legal representative" (15A NCAC 18A .1937). If the owner does not sign the application himself or herself, they can submit any one of the following documents to designate their legal representative:

Power of Attorney; Real Estate Contract; Estate executor; Bankruptcy trustee; Court ordered guardianship

In the absence of the above documentation, the property owner may provide the local health department with documentation that designates a legal representative. A property owner may:

Complete this form to document his or her legal representative, or provide his or her own form that contains the information in this form.

If there are multiple property owners, then all property owners must sign the form that designates a legal representative.

By signing a form that designates a legal representative for purposes of 15A NCAC 18A .1937, the property owner authorizes that representative to act on their behalf in matters pertaining to the application and permitting process, including signing or receiving any application, document or permit. The owner retains full responsibility to meet all permit conditions specified by the local health department.

I, Nanette M. Stucker, am the legal owner(s) of the property located at 243 Indian Trail Mooresville, NC, identified as PIN (Parcel Identification Number) _____, located in Iredell County, North Carolina.

I do hereby authorize (**print legal representative/company name**) Lentz Septic/Wastewater Mgmt, to act as an agent on my behalf in applying for/signing/obtaining any of the documents described below.

- Application for Improvement Permit (IP) / Authorization to Construct (AC)
- Improvement Permit (IP) / Authorization to Construct (AC)
- Application for soil-site evaluation (new/repair)
- Application/permit for private drinking water well/well abandonment
- Application for Compliance Inspection

I agree to abide by all decisions and/or conditions between the legal representative acting on my behalf and the Iredell County Department of Public Health, Environmental Health Division.

Nanette M. Stucker 3/26/2020

Signature of Owner(s) Date Signature of Witness Date

Please return this signed form to the appropriate office:

Mooresville - Environmental Health
ronda.hart@co.iredell.nc.us
Fax: 704-662-3239
610 E. Center Avenue, Mooresville, NC 28115

Statesville - Environmental Health
adrienne.shea@co.iredell.nc.us
Fax: 704-871-3483
349 N. Center Street, Statesville, NC 28677