IREDELL COUNTY HEALTH DEPARTMENT

STATESVILLE 704-878-5305 MOORESVILLE 704-664-5281

IMPROVEMENT PERMIT / AUTHORIZATION TO CONSTRUCT / OPERATION PERMIT / EXISTING SYSTEM INSPI

PERMIT# 145488 PIN# 4626332604 DATE 12-2

OWNER OR APPLICANT Lonnie & Brenda Lenaburg PHONE: Business Home 704-758-2531

ADDRESS 109 Aquarius Ln Mooresville NC 28117

LOCATION Brawley school Rd TR Chuckwood TR Indian Tr Th Aquarius

SUBDIVISION CL&T BLOCK / SECTION 7 LOT 27 LOT AREA .589 Ac SITE CLASS. PS DESIGN FLOW 360gpd L.T.A.R. .275 gpd/ft²

Septic Tank: 1000 Gallons: STB 794 Date 1-15-08

Pump Tank: 1000 Gallons: PT 283 Date 3-28-08

Pump Make: Gould's Model WE0712H Serial No.

Nitrification Field: No Fields 1 Square Feet Linear Feet 220

No Lines 4 Trench Width 24" min. Max Trench Bottom Depth 32" Gravel Depth NA ☐ Gravity ☑ Pressure

☒ New System ☐ Repair ☐ Expansion System Type: I II III IV V VI

System Description: LPPPBPS

Repair System Description: Pre-treatment Drip

Maintenance Agreement Required: ☒ Yes ☐ No

☒ House/Mod. Home No. Bedrooms 3

☐ Mobile Home No. Persons 6

☐ Business No. Employees

☐ Other

Water Supply: ☒ Individual ☐ Public ☐ Community

☐ Slab ☐ Crawl Space ☒ Basement w/plumbing ☐ Basement wo/plumbing

Comments:/Conditions:

In-line pump filter required 8-5-08 sm
3/16" hole drilled


Comments:/Conditions:

Before OP: well abandonment record must be submitted. Received 8-14-08 - Attached

INITIAL SITE SKETCH

See Plan from SHME

AS BUILT SKETCH

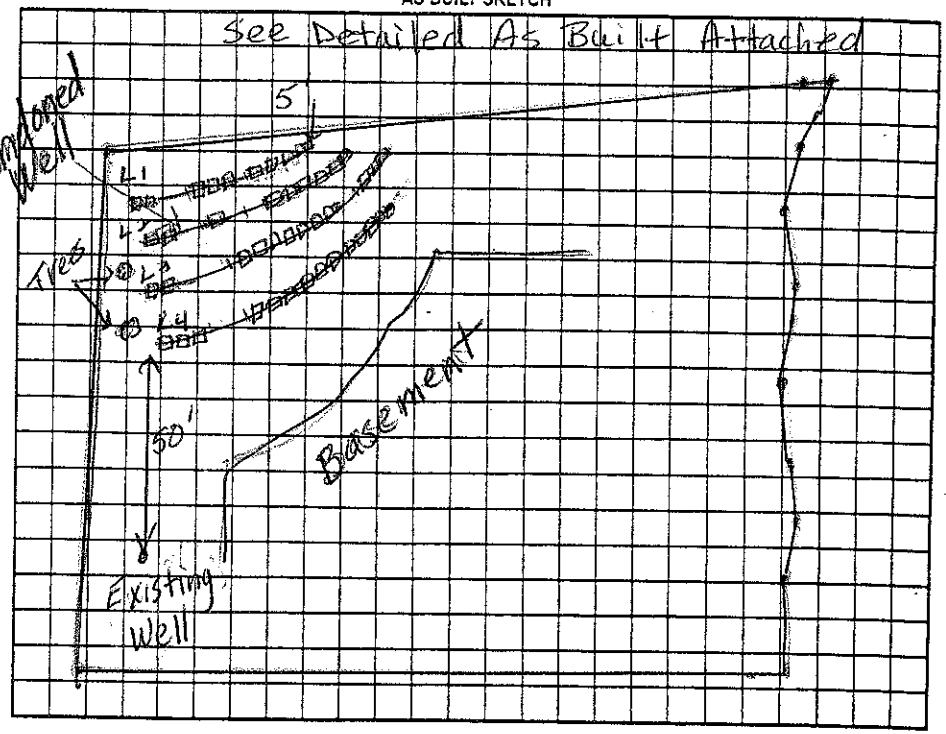

Permit can be suspended or revoked if any false information is supplied toward securing the permit/any unauthorized changes are made to the site/any unauthorized changes are made in the installation of the system. Improvement Permit with plat valid without expiration ☐ Improvement Permit with site plan valid for sixty months ☒ Authorization to Construct is valid for a period equal to that of Improvement Permit – not to exceed sixty months.

Signed: Lonnie D Lenaburg date 1-2-08

Improvement Permit by: Judy Mefill date 12-21-07

Authorization to Construct by: Wesley Sparks RS. date 5/14/08

Installed by: Shawn Penwarden 8294 Sos Grading 704-309-9354

Operation Permit by: Marie H Dolan RS date 5/7/09

Existing System Inspection by: date

HEALTH DEPT. COPY: WHITE OWNER COPY (FINAL): YELLOW OWNER COPY (INITIAL): PINK