

As Built 109 Aquarius

L1

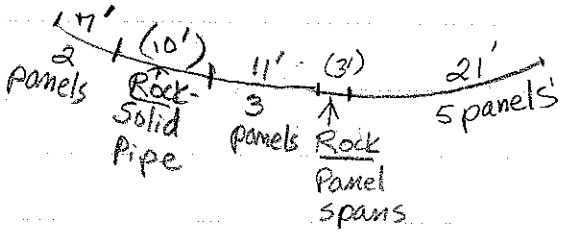


39' usable
52' total line length

L2

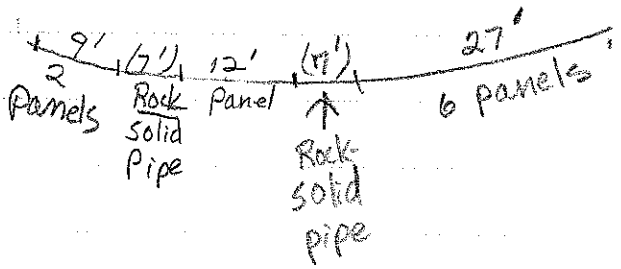


48' usable
62' total line length

L3

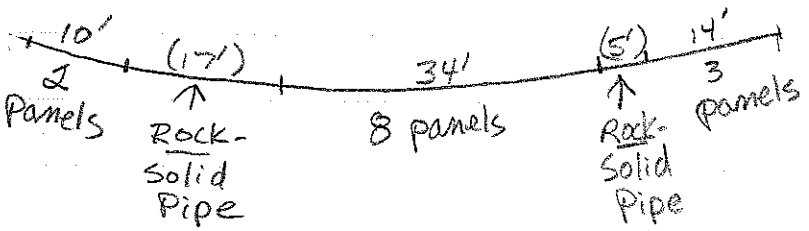

58' usable
80' total line length

L4

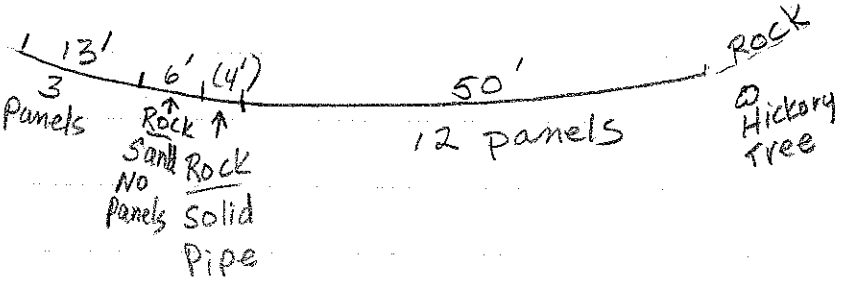

63' usable
73' total line length

Brady Freeman R.S., of Rollans Soil & Env. Services, present at installation on 8/4/08 as consultant hired by owner. Probed rock areas & helped measure line. gm