IREDELL COUNTY HEALTH DEPARTMENT

STATESVILLE 704-878-5305 $130 MOORESVILLE 704-664-5281 2.30

IMPROVEMENT PERMIT / AUTHORIZATION TO CONSTRUCT / OPERATION PERMIT / EXISTING SYSTEM INSPECTION

PERMIT# 126493 PIN# 4626-33-3236 DATE 3-23-05

OWNER OR CONTRACTOR Mid Atlantic Custom Builders Bill Bethune PHONE: Business 980 722-0230 Home

ADDRESS P.O. 3792 Mooresville, NC 28117

LOCATION Brawley School Rd TR, Chuckwood TR Indian Trial

SUBDIVISION Watertree Land BLOCK / SECTION LOT 23 LOT AREA 45,000 sq ft SITE CLASS PS DESIGN FLOW 480 gpd L.T.A.R. .25

Septic Tank: 1000 Gallons; STB 794 Date 6-5-04

Pump Tank: Gallons; PT Date

Pump Make: Model Serial No.

Nitrification Field: No Fields 1 Square Feet 1440' Linear Feet 480'

No Lines 6@80' Trench Width 36" Max Trench Bottom Depth 18" Gravel Depth N/A

[X] New System [ ] Repair System Type: I II III IV V VI Shallow

System Description: Gravity - 25% Reduction

Repair System Description: Pump - 25% Reduction

Maintenance Agreement Required: [ ] Yes [X] No

[X] House/Mod. Home No. Bedrooms 4

[ ] Mobile Home No. Bathrooms

[ ] Business No. Employees

[ ] Other

[ ] Slab [X] Crawl Space [ ] Basement w/plumbing [ ] Basement wo/plumbing


Water Supply: [X] Individual [ ] Public [ ] Community

Comments/Conditions:

Potential Well Site

Area of Soil

INITIAL SITE SKETCH

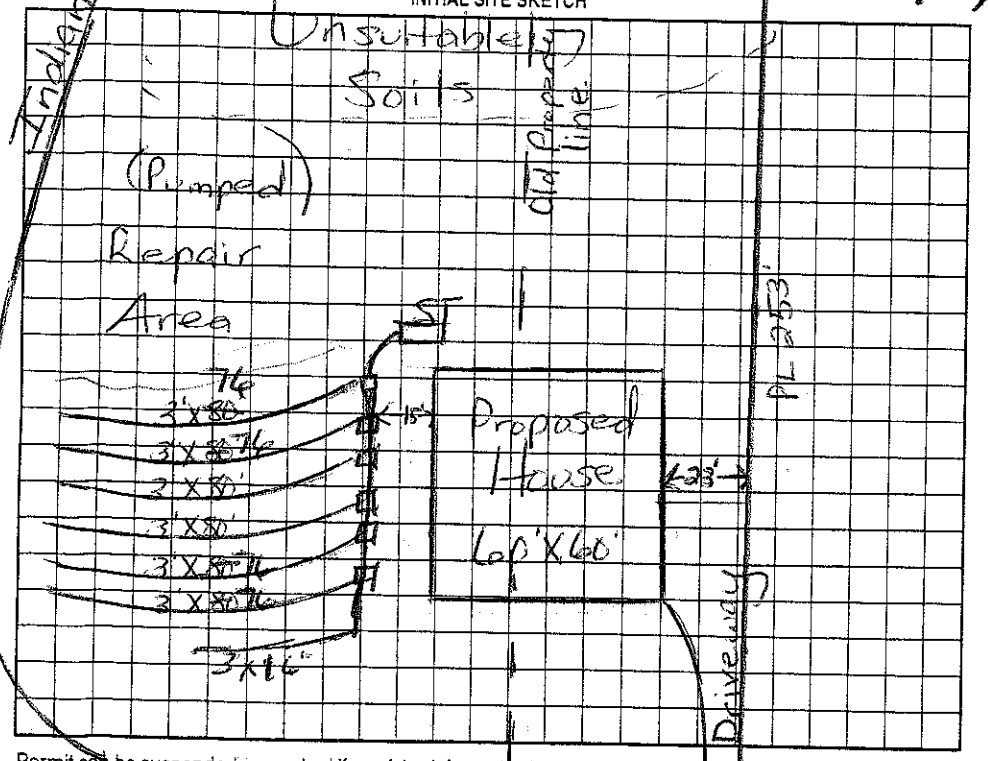

Comments/Conditions: Keep Drainfield 15ft from top of embankment or cuts 2ft or greater. Must stub out plumbing high to gravity feed ST; otherwise pump. Must place house as shown on permit

AS BUILT SKETCH

Owner must provide revised & recorded Copy of Survey/plat that shows Combination of Lot #23 with lot #22. Okay 7/12/05 — See attached

Installed Quick 4 for Drainfield & Drop boxes

Note: House further back than drawn

Permit can be suspended or revoked if any false information is supplied toward securing the permit/any unauthorized changes are made to the site/any unauthorized changes are made in the installation of the system. Improvement Permit with plat valid without expiration. Improvement Permit with site plan valid for sixty months. Authorization to Construct is valid for a period equal to that of Improvement Permit – not to exceed sixty months.

Signed: Bill Bethune Indian Trial date 3-24-05

Improvement Permit by: Maria H. Dotson RS date 3/23/05

Authorization to Construct by: Maria H. Dotson RS date 7/12/05

Installed by: Howard's Backhoe

Operation Permit by: Maria H. Dotson RS date 7/12/06

Existing System Inspection by: date

HEALTH DEPT. COPY: WHITE OWNER COPY (FINAL): YELLOW OWNER COPY (INITIAL): PINK