# IREDELL COUNTY HEALTH DEPARTMENT

TESVILLE 704-878-5305 $130 MOORESVILLE 704-664-5281 2130

## IMPROVEMENT PERMIT / AUTHORIZATION TO CONSTRUCT / OPERATION PERMIT / EXISTING SYSTEM INSPECTION

PERMIT# 126493 PIN# 4626-33-3236

OWNER OR CONTRACTOR Mid Atlantic Custom Builders PHONE: Business 980 722-0238 Bill Bethune Home UNNUMBERED DATE 3-23-05

ADDRESS P.O. 3792 Mooresville, NC 28117

LOCATION Brawley School Rd TR Chuckwood TR Indian Trial

SUBDIVISION Watertree Land BLOCK / SECTION 2 LOT 23 & P132 LOT AREA 45,000 sq ft SITE CLASS. FS DESIGN FLOW 480gpd L.T.A.R. .25

Septic Tank: 1000 Gallons; STB 794 Date 6-5-04

Pump Tank: _____ Gallons; PT _____ Date _____

Pump Make: _____ Model _____ Serial No. _____

Nitrification Field: No Fields 1 Square Feet 1440' Linear Feet 480'

No Lines 4 @ 80' Trench Width 36" Max Trench Bottom Depth 18" Gravel Depth N/A

☒ New System ☐ Repair System Type: I II III IV V Shallow

System Description: Gravity - 25% Reduction

Repair System Description: Pump - 25% Reduction

Maintenance Agreement Required: ☐ Yes ☒ No

☒ House/Mod. Home No. Bedrooms 4

☐ Mobile Home No. Bathrooms ____

☐ Business No. Employees ____


☐ Other _____

☐ Slab ☒ Crawl Space ☐ Basement w/plumbing ☐ Basement wo/plumbing

Water Supply: ☒ Individual ☐ Public ☐ Community

Comments:/Conditions:

INITIAL SITE SKETCH

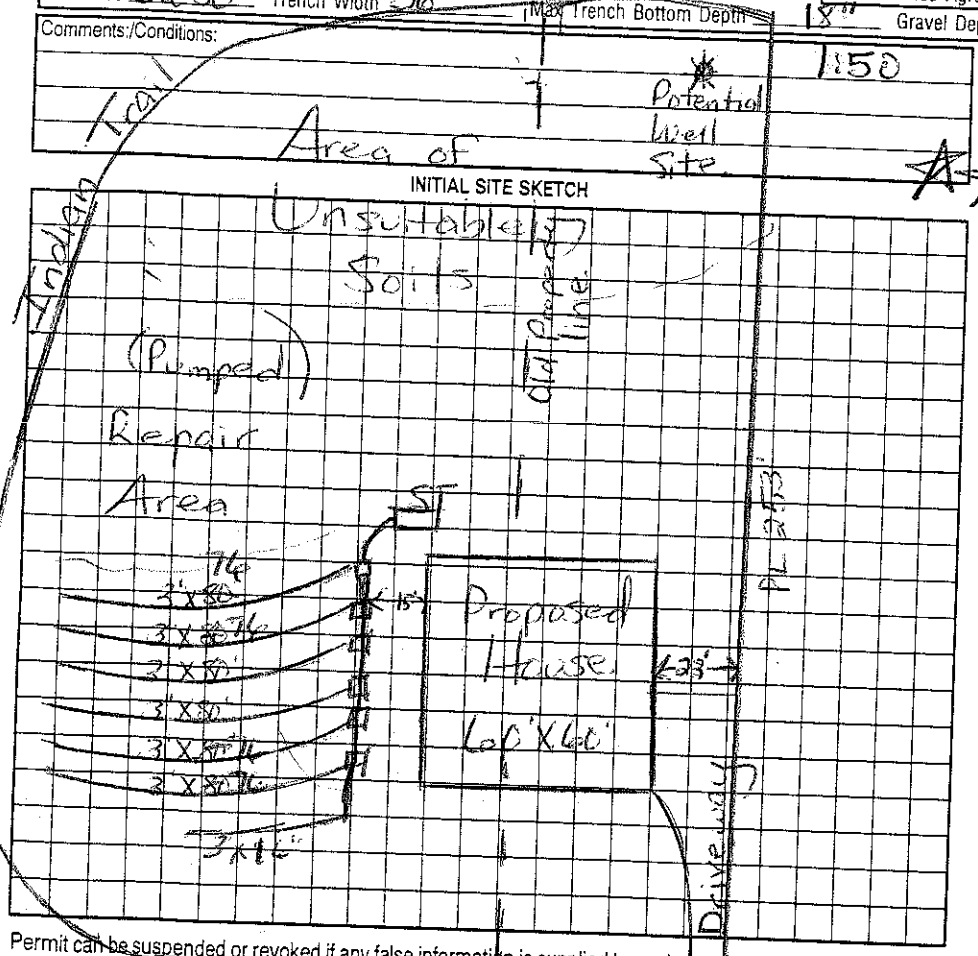


Comments:/Conditions: Keep Drainfield 15Ft from top of embankment or cuts 2Ft or greater. Must stub out plumbing high to gravity feed ST; otherwise pump. Must place house as shown on permit

AS BUILT SKETCH

Owner must provide revised & recorded Copy of survey/plat that shows Combination of lot #23 with lot #22. OKay 7/12/05 — see attached
Tested Quick 4 for Drainfield & Drop boxes
Note: House further back than drawn

Permit can be suspended or revoked if any false information is supplied toward securing the permit/any unauthorized changes are made to the site/any unauthorized changes are made in the installation of the system. Improvement Permit with plat valid without expiration. Improvement Permit with site plan valid for sixty months. Authorization to Construct is valid for a period equal to that of Improvement Permit – not to exceed sixty months.

Signed: Bill Bethune date 3-24-05

Improvement Permit by: Maria H. Dotson RS date 3/23/05

Authorization to Construct by: Maria H. Dotson RS date 7/12/05

Installed by: Howard's Backhoe

Operation Permit by: Maria H. Dotson RS date 7/12/06

Existing System Inspection by: _____ date _____

HEALTH DEPT. COPY: WHITE OWNER COPY (FINAL): YELLOW OWNER COPY (INITIAL): PINK

Cell 951-743-3792 Gary Tooke