IREDELL COUNTY HEALTH DEPARTMENT

Statesville Phone TR 3-7271 Mooresville Phone NO 3-1271

PERMIT TO INSTALL SEPTIC TANK

Permit No. 101 Permit Date 6 - 13 - 1972

Owner A. W. Woods Address Charlotte

Installed By Ervin Address Mooresville


Location of Property 1100 to 2nd Paved Rd past Johns Trading Post Go to end go right go to big Forks ~~Lake~~ stay straight.

| Tank | | Capacity | | Length of Lines | | Fixtures | |
|---|---|---|---|---|---|---|---|
| Block | ( ) | 1000 | ( ) | 225' | ( ) | No. of Baths | (1) |
| Precast | (✓) | 1250 | ( ) | 250' | ( ) | Dishwasher | (no |
| | | 1500 | ( ) | Other 180' | | Garbage Grdr. | (no |
| | | Other 500 gal | | | | Other | |

NOTIFY HEALTH DEPARTMENT AT LEAST EIGHT HOURS BEFORE TANK IS TO BE INSPECTED.

Final Inspection 6 - 13 - 1972 Approved ( ) Disapproved ( )

Remarks This System was installed in a very difficult place. There were many large rocks underneath the surface and this kept them from getting hole big enough for minimum line & minimum Tank. system will take extra maintance and very limited use.

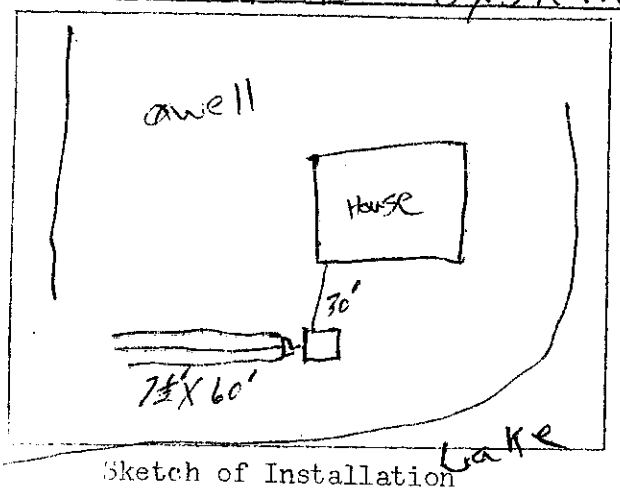


Sketch of Installation

Sanitarian J. C. Moore