IREDELL COUNTY HEALTH DEPARTMENT

STATESVILLE 704-878-5305 MOORESVILLE 704-664-5281

IMPROVEMENT PERMIT / AUTHORIZATION TO CONSTRUCT / OPERATION PERMIT / EXISTING SYSTEM INSPECTI

280,00 Paid

PERMIT# 126280 PIN# 4626 35 2861 DATE 6/13/05

OWNER OR CONTRACTOR John Gauthier PHONE: Business Home 704-365-6201

ADDRESS 728 Peranna Pl. Charlotte, NC 28211620

LOCATION SE 317 Kemp Rd.

SUBDIVISION CL+T BLOCK / SECTION 8 LOT 115 LOT AREA ~1.0 Ac SITE CLASS PS DESIGN FLOW 240 L.T.A.R. .3

Septic Tank: 1000 Gallons; STB 805 Date 6/17/05

Pump Tank: 1000 Gallons; PT 302 Date 2/12/06

Pump Make: ZOELLER Model N98-3 Serial No.

Nitrification Field: No Fields 1 Square Feet 800 Linear Feet 266

No Lines 3@88' Trench Width 3' Max Trench Bottom Depth 3' Gravel Depth 12"

☒ New System ☐ Repair System Type: I, II, III, IV, V, VI

System Description: PM → Conventional

Repair System Description: < 1983

Maintenance Agreement Required: ☐ Yes ☒ No

☒ House/Mod. Home ☐ Mobile Home ☐ Business ☐ Other

No. Bedrooms 2 No. Bathrooms 2 No. Employees


Water Supply: ☐ Individual ☐ Public ☐ Community

☐ Slab ☒ Crawl Space ☐ Basement w/plumbing ☐ Basement wo/plumbing


Comments/Conditions: "Accepted System"

Comments/Conditions: EZ Flow chamber bed

INITIAL SITE SKETCH (1" = 50')

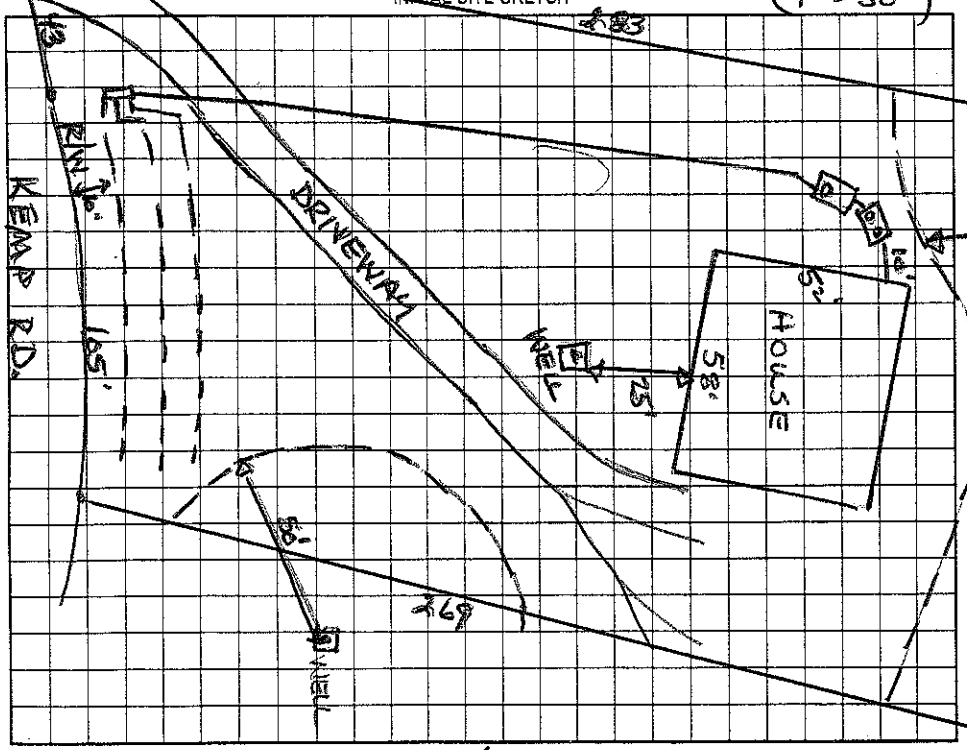

AS BUILT SKETCH

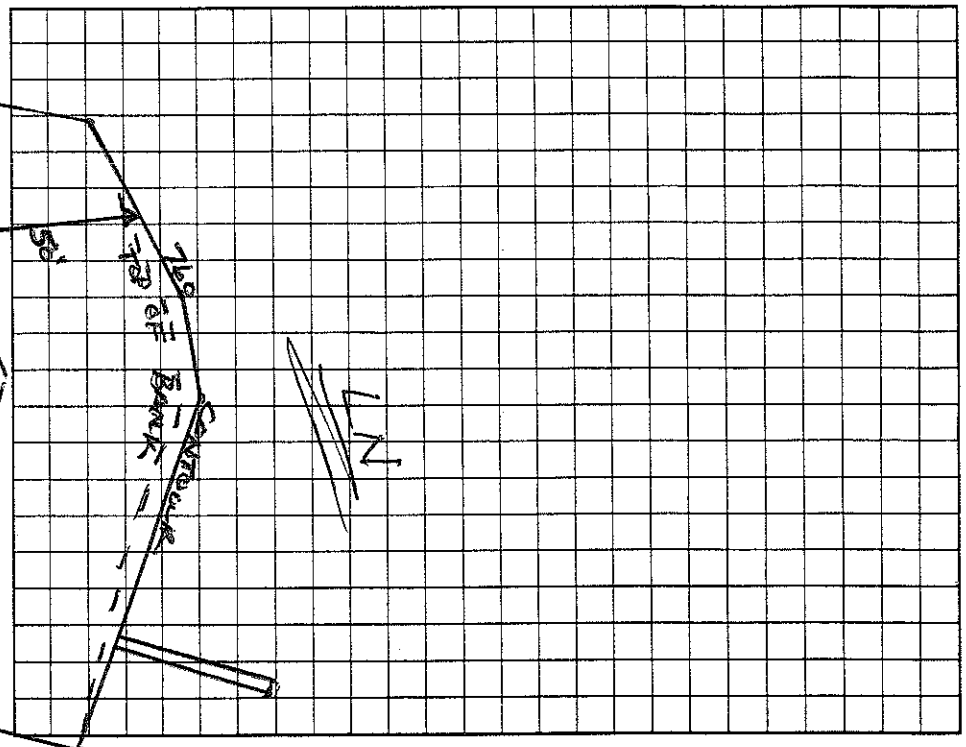

Permit can be suspended or revoked if any false information is supplied toward securing the permit/any unauthorized changes are made to the site/any unauthorized changes are made in the installation of the system. Improvement Permit with plat valid without expiration. Improvement Permit with site plan valid for sixty months. Authorization to Construct is valid for a period equal to that of Improvement Permit – not to exceed sixty months.

Signed: ✕ John O. Gauthier date 6/17/05 Installed by: WP Mobile + Assoc.

Improvement Permit by: Wesley Sparks RS. date 6/13/05 Operation Permit by: Wesley Sparks RS. date 3/28/06

Authorization to Construct by: Wesley Sparks RS. date 6/13/05 Existing System Inspection by: date

HEALTH DEPT. COPY: WHITE OWNER COPY (FINAL): YELLOW OWNER COPY (INITIAL): PINK