IREDELL COUNTY HEALTH DEPARTMENT

STATESVILLE 704-878-5305 MOORESVILLE 704-664-5281

IMPROVEMENT PERMIT / CERTIFICATE OF COMPLETION / OPERATION PERMIT / EXISTING SYSTEM INSPECTION

PROPERTY DESCRIPTION NO. 15704 DATE June 8, '93 4626352926 MAP NO. 2F-3-A-116

OWNER OR CONTRACTOR Dawna R. Hawbarker PHONE: Business Home 933-3130

ADDRESS 2306 Englewood, Kannapolis NC 28083

LOCATION 1100 TR 1115 TR 1445 (Kemp) past Cooley Rd. ~¼ mile on left

SUBDIVISION Crescent Lake Norman BLOCK / SECTION 8 LOT 116 LOT AREA Existing ~3/4 AC SITE CLASS. PS L.T.A.R. .3-.4

Water Supply: ☑ Individual ☐ Community ☐ Public

Septic Tank Ex (1000) Gallons; STB ____ Date ____

Pump Tank: ____ Gallons; PT ____ Date ____

Nitrification Field: No. Fields 2 Square Feet NEW (450) Linear Feet NEW (150)

No. Lines NEW (2) Trench Width 36" Trench Depth 48"+ Gravel Depth 12"

☐ New System ☑ Repair System Type: I, II, III, IV, V, VI

System Description: grav. bed

Repair System Description: grav. contractor w/ BR valve

Maintenance Agreement Required: ☐ Yes ☑ No

☑ House/Mod. Home No. Bedrooms 3

☐ Mobile Home No. Bathrooms 3

☐ Business No. Employees ____

☐ Other ____

Garbage Disposal: ☐ Yes ☑ No

Auto. Dishwasher: ☑ Yes ☐ No

Auto. Washing Machine: ☑ Yes ☐ No


Other ____

☐ Slab ☑ Crawl Space ☐ Basement w/plumbing ☐ Basement wo/plumbing

Comments New trencher deep but no problem noted with soil.

INITIAL SITE SKETCH

AS BUILT SKETCH

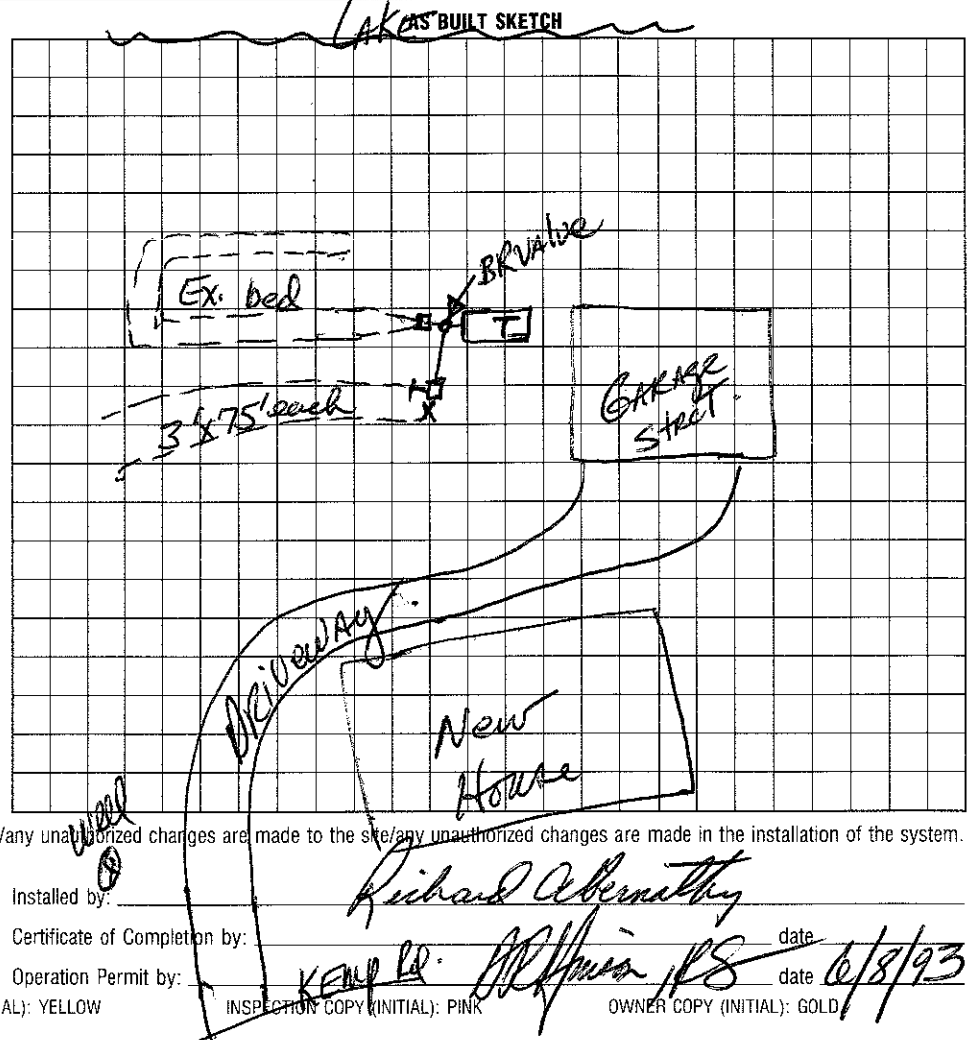

I understand that this permit can be suspended or revoked if any false information is supplied toward securing the permit/any unauthorized changes are made to the site/any unauthorized changes are made in the installation of the system. Improvement Permit is valid for 60 months from date of issuance.

Signed: ____ Installed by: Richard Abernathy

Improvement Permit by: ____ date ____ Certificate of Completion by: ____ date ____

Existing System Inspection by: ____ date ____ Operation Permit by: ____ date 6/8/93

HEALTH DEPT. COPY: WHITE INSPECTION COPY (FINAL): GREEN OWNER COPY (FINAL): YELLOW INSPECTION COPY (INITIAL): PINK OWNER COPY (INITIAL): GOLD