IREDELL COUNTY HEALTH DEPARTMENT

STATESVILLE 704-878-5305 MOORESVILLE 704-664-5281

IMPROVEMENT PERMIT / AUTHORIZATION TO CONSTRUCT / OPERATION PERMIT / EXISTING SYSTEM INSPECTION

PERMIT# 119477 PIN# ~~4626-35-6001-376~~ 4626-35-5974 DATE 6/25/04

OWNER OR CONTRACTOR THE FARMS LLC / L Shawn Ogden PHONE: Business 660-1185 Home

ADDRESS 2214 BRAWLEY SCHOOL / RD MOORESVILLE NC 28115

LOCATION BRAWLEY SCHOOL - TR McKENDREE - TL KEMP - ON RT 318 Kemp

SUBDIVISION FARMS BLOCK / SECTION 3 LOT 376 LOT AREA 1.1Ac SITE CLASS. RS DESIGN FLOW 480GPD L.T.A.R. .36PP/RTA

Septic Tank: ~~1500~~ Gallons; STB 449 Date 5/5/04

Pump Tank: Gallons; PT Date

Pump Make: Model Serial No.

Nitrification Field: No Fields 1 Square Feet 1200 Linear Feet 400

No Lines 5@80' Trench Width 36" Max Trench Bottom Depth 36" Gravel Depth N/A

☑ New System ☐ Repair System Type: I, II, III, IV, V, VI

System Description: GRAVITY 25% REDUCTION

Repair System Description: SAME

Maintenance Agreement Required: ☐ Yes ☑ No

☑ House/Mod. Home No. Bedrooms 4

☐ Mobile Home No. Bathrooms 4

☐ Business No. Employees

☐ Other


☐ Slab ☑ Crawl Space ☐ Basement w/plumbing ☐ Basement wo/plumbing

Water Supply: ☐ Individual ☐ Public ☐ Community


Comments/Conditions: 12/1/05 Renewed Building plans; essentially in compliance with AC. 1"=50'

Comments/Conditions:

INITIAL SITE SKETCH

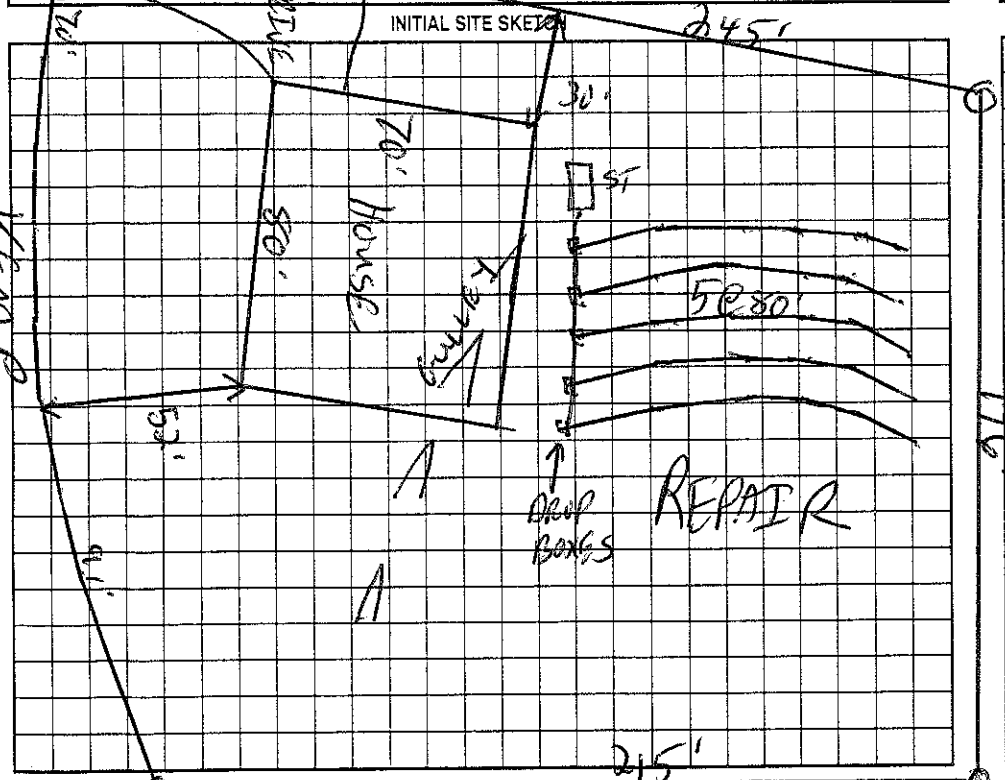

AS BUILT SKETCH

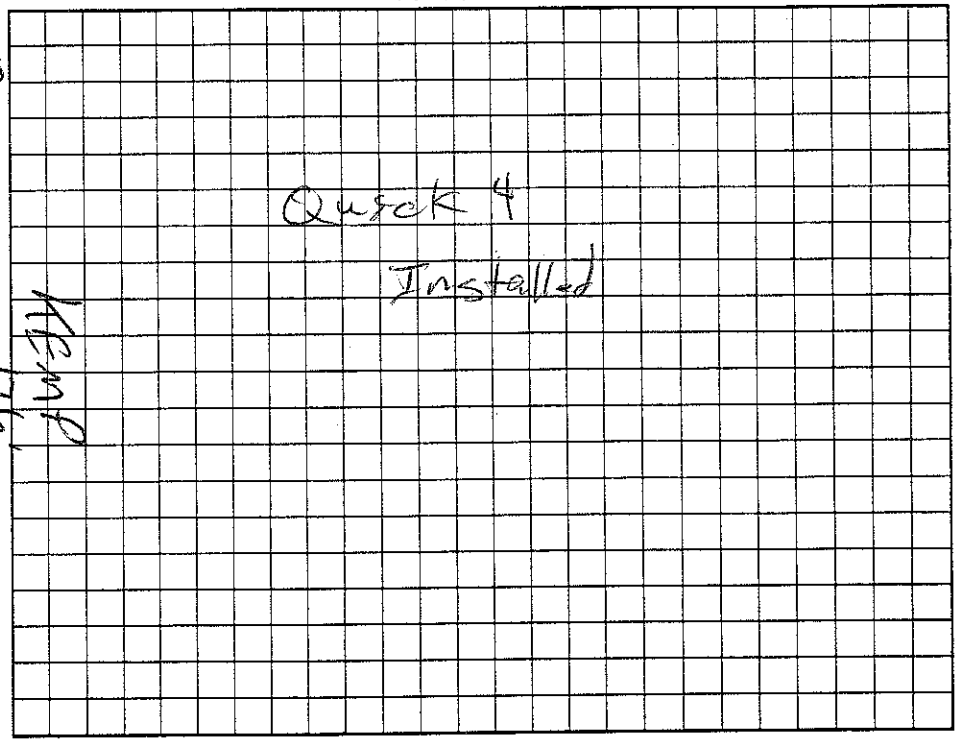

Permit can be suspended or revoked if any false information is supplied toward securing the permit/any unauthorized changes are made to the site/any unauthorized changes are made in the installation of the system. Improvement Permit with plat valid without expiration. Improvement Permit with site plan valid for sixty months. Authorization to Construct is valid for a period equal to that of Improvement Permit – not to exceed sixty months.

Signed: date 7-12-04 Installed by: Abernathy

Improvement Permit by: date 6/25/04 Operation Permit by: RS date 6/21/05

Authorization to Construct by: Martha H. Dolan RS date 12/7/05 Existing System Inspection by: date

HEALTH DEPT. COPY: WHITE OWNER COPY (FINAL): YELLOW OWNER COPY (INITIAL): PINK