3.30

IREDELL COUNTY HEALTH DEPARTMENT

STATESVILLE 704-878-5305 MOORESVILLE 704-664-5281

IMPROVEMENT PERMIT / AUTHORIZATION TO CONSTRUCT / OPERATION PERMIT / EXISTING SYSTEM INSPECTION

PERMIT# 19479 PIN# ~~4026 38 4001. 375~~ 4626356447 DATE 6/25/04

OWNER OR CONTRACTOR THE FARMS LLC PHONE: Business 660-1185 Home

ADDRESS 2214 BRAWLEY SCHOOL - MOORESVILLE NC 28115

LOCATION BRAWLEY SCHOOL - JR MCKENDREE - TL KEMP - ON RT

SUBDIVISION THE FARMS BLOCK / SECTION LOT 375 LOT AREA .85AC SITE CLASS. BS DESIGN FLOW 480GPD L.T.A.R. .36 PD/FT2

Septic Tank: 1000 Gallons; STB 338 Date 12-16-04

Pump Tank: Gallons; PT Date

Pump Make: Model Serial No.

Nitrification Field: No Fields 1 Square Feet 1200 Linear Feet 400

No Lines 5@80' Trench Width 36" Max Trench Bottom Depth 36" Gravel Depth N/A

☑ New System ☐ Repair System Type: I II III IV V VI

System Description: GRAVITY 25% REDUCTION

Repair System Description: PUMP 25% REDUCTION

Maintenance Agreement Required: ☐ Yes ☑ No

☑ House/Mod. Home ☐ Mobile Home ☐ Business ☐ Other

No. Bedrooms 4 No. Bathrooms 4 No. Employees


☐ Slab ☑ Crawl Space ☐ Basement w/plumbing ☐ Basement wo/plumbing

Water Supply: ☐ Individual ☐ Public ☑ Community


Comments/Conditions: STUB OUT PLUMBING- HIGH TO ACHIEVE GRAVITY- DO NOT CUT HOUSE PAD

Comments/Conditions: 1/10/07 Checked Upper 3 lines & ST
1/24/07 Checked other 2 lines

INITIAL SITE SKETCH

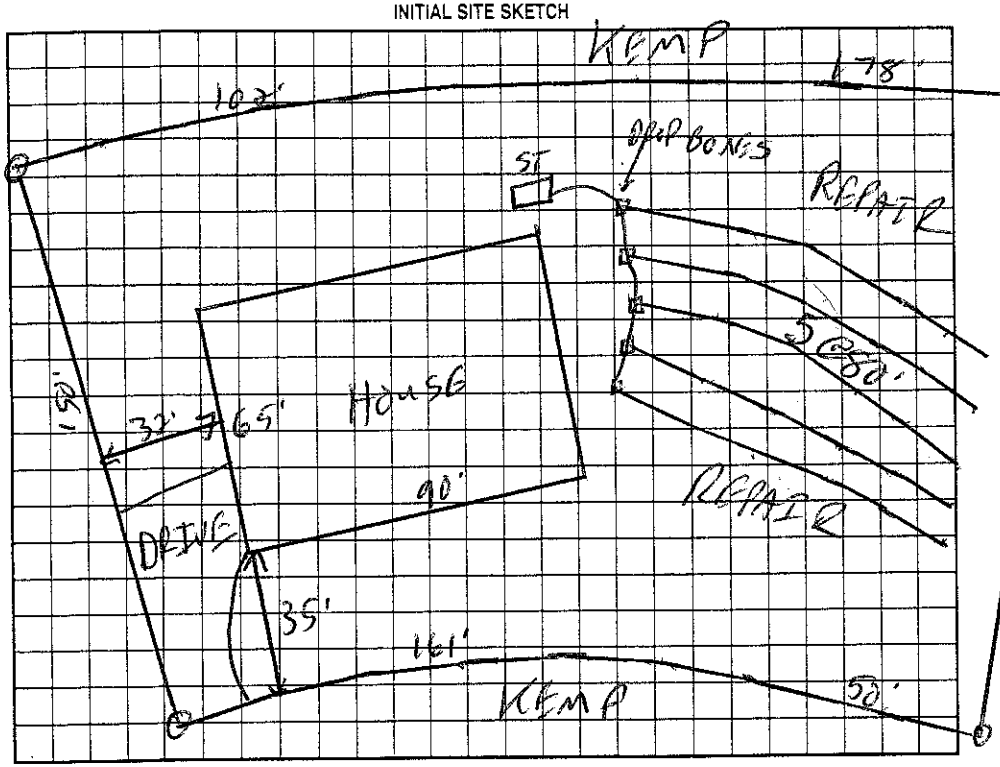

AS BUILT SKETCH

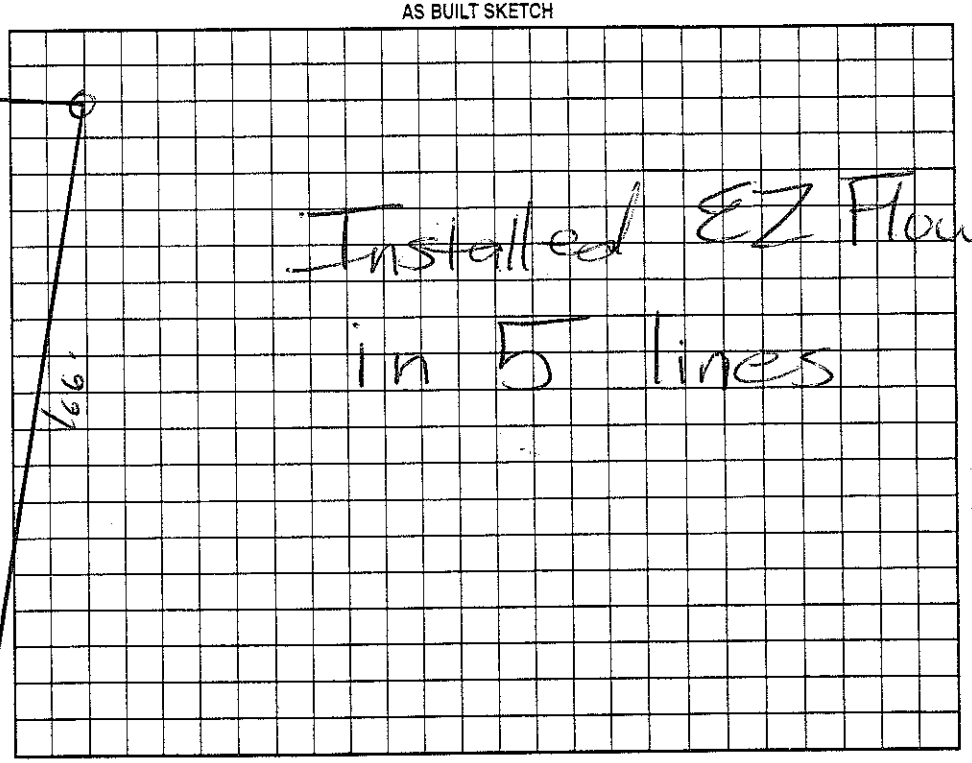

Permit can be suspended or revoked if any false information is supplied toward securing the permit/any unauthorized changes are made to the site/any unauthorized changes are made in the installation of the system. Improvement Permit with plat valid without expiration. Improvement Permit with site plan valid for sixty months. Authorization to Construct is valid for a period equal to that of Improvement Permit – not to exceed sixty months.

Signed: date 7-12-04

Improvement Permit by: date 6/25/04

Authorization to Construct by: Wesley Sparks RS date 9/14/06

Installed by: R & H date 1/24/07

Operation Permit by: Mariah Dotson RS

Existing System Inspection by: date

HEALTH DEPT. COPY: WHITE OWNER COPY (FINAL): YELLOW OWNER COPY (INITIAL): PINK