IREDELL COUNTY HEALTH DEPARTMENT

STATESVILLE 704-878-5305 130.00 Paid MOORESVILLE 704-664-5281

IMPROVEMENT PERMIT / AUTHORIZATION TO CONSTRUCT / OPERATION PERMIT / EXISTING SYSTEM INSPECTION

PERMIT# 124929 PIN# 4626-36-0555 DATE 12/7/04

OWNER OR CONTRACTOR Jean Gyess PHONE: Business _____ Home 704-895-5880

ADDRESS 16418 Pinwheeny Rd Cornelius NC 28031

LOCATION BSR, TR McKendree, TL Kemp, on Lt # 359

SUBDIVISION _____ BLOCK / SECTION _____ LOT _____ LOT AREA 0.92 Ac SITE CLASS PS DESIGN FLOW 480 L.T.A.R. 0.3

Septic Tank: 1000 Gallons; STB 1012 Date 7/18/04
Pump Tank: 1000 Gallons; PT 17 Date 10/24/04
Pump Make: Gawlds Model WE05111M Serial No. _____
Nitrification Field: No Fields 1 Square Feet 1200 Linear Feet 400
No Lines 4 @ 100' Trench Width 36" Max Trench Bottom Depth 36" Gravel Depth —

☒ New System ☐ Repair System Type: I, II, (III), IV, V, VI
System Description: PM 25% Reduction
Repair System Description: LP Panel Block
Maintenance Agreement Required: ☐ Yes ☒ No

☐ House/Mod. Home No. Bedrooms 4
☒ Mobile Home No. Bathrooms ____
☐ Business No. Employees ____
☐ Other _____


☐ Slab ☒ Crawl Space ☐ Basement w/plumbing ☐ Basement wo/plumbing

Water Supply: ☒ Individual ☐ Public ☐ Community


Comments:/Conditions:
1"=50'

Comments:/Conditions:

INITIAL SITE SKETCH

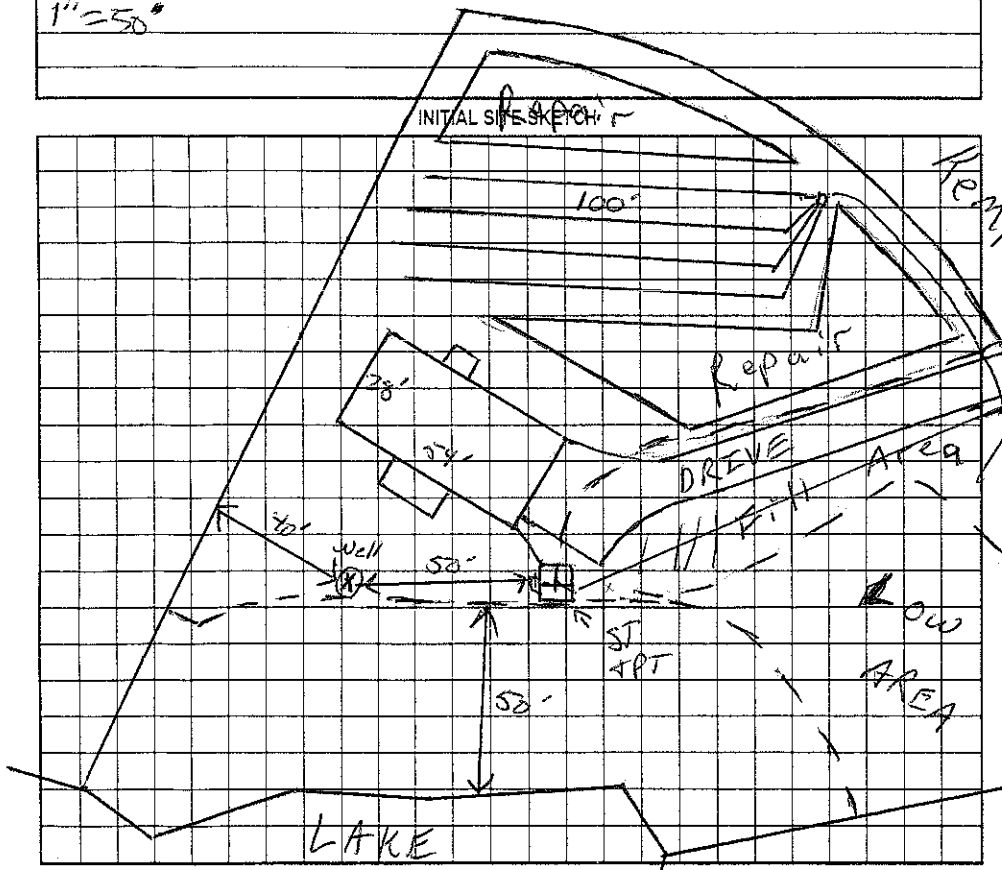

AS BUILT SKETCH

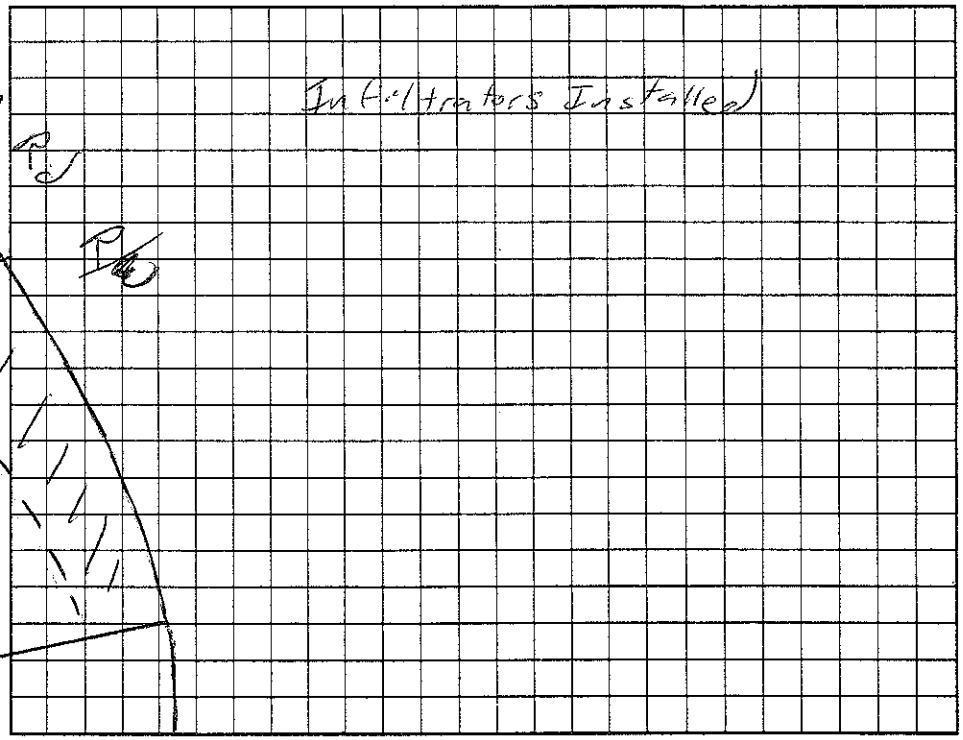

Permit can be suspended or revoked if any false information is supplied toward securing the permit/any unauthorized changes are made to the site/any unauthorized changes are made in the installation of the system. Improvement Permit with plat valid without expiration. Improvement Permit with site plan valid for sixty months. Authorization to Construct is valid for a period equal to that of Improvement Permit – not to exceed sixty months.

Signed: _____ date 12-13-04 Installed by: Craig Thompson

Improvement Permit by: RS date 12/7/04 Operation Permit by: RS date 4/20/05

Authorization to Construct by: RS date 12/7/04 Existing System Inspection by: _____ date _____

HEALTH DEPT. COPY: WHITE OWNER COPY (FINAL): YELLOW OWNER COPY (INITIAL): PINK