IREDELL COUNTY HEALTH DEPARTMENT

STATESVILLE 704-878-5305 MOORESVILLE 704-664-52..

$130 W

IMPROVEMENT PERMIT / AUTHORIZATION TO CONSTRUCT / OPERATION PERMIT / EXISTING SYSTEM INSPECTION

PERMIT# ~~106150~~ 120024 PIN# 4626-36-8566 DATE 6/21/02

OWNER OR CONTRACTOR Jon Shoemaker PHONE: Business _____ Home 704-786-2997

ADDRESS 3900 Zion Ch. Rd. Concord NC 28025

LOCATION Brawley Sch, TR McKendree, TL Kemp, TL Agnew on corner

SUBDIVISION CL+T BLOCK / SECTION 8 LOT 79/164 LOT AREA 1.62 AC SITE CLASS PS DESIGN FLOW 480 L.T.A.R. 0.3

Septic Tank: 1000 Gallons; STB 312 Date 1/7/05

Pump Tank: 1000 Gallons; PT 27 Date 12/28/04

Pump Make: _____ Model _____ Serial No. _____

Nitrification Field: No Fields 1 Square Feet 1200 Linear Feet 400

No Lines 3@133' Trench Width 36" Max Trench Bottom Depth 36" Gravel Depth —

☒ New System ☐ Repair System Type: I II III IV V VI

System Description: Proc. Man. 25% Reduction

Repair System Description: same

Maintenance Agreement Required: ☐ Yes ☒ No

☒ House/Mod. Home ☐ Mobile Home ☐ Business ☐ Other

No. Bedrooms 4 No. Bathrooms 4 No. Employees ____


☐ Slab ☐ Crawl Space ☒ Basement w/plumbing ☐ Basement wo/plumbing

Water Supply: ☒ Individual ☐ Public ☐ Community

Comments:/Conditions:

Comments:/Conditions:

INITIAL SITE SKETCH

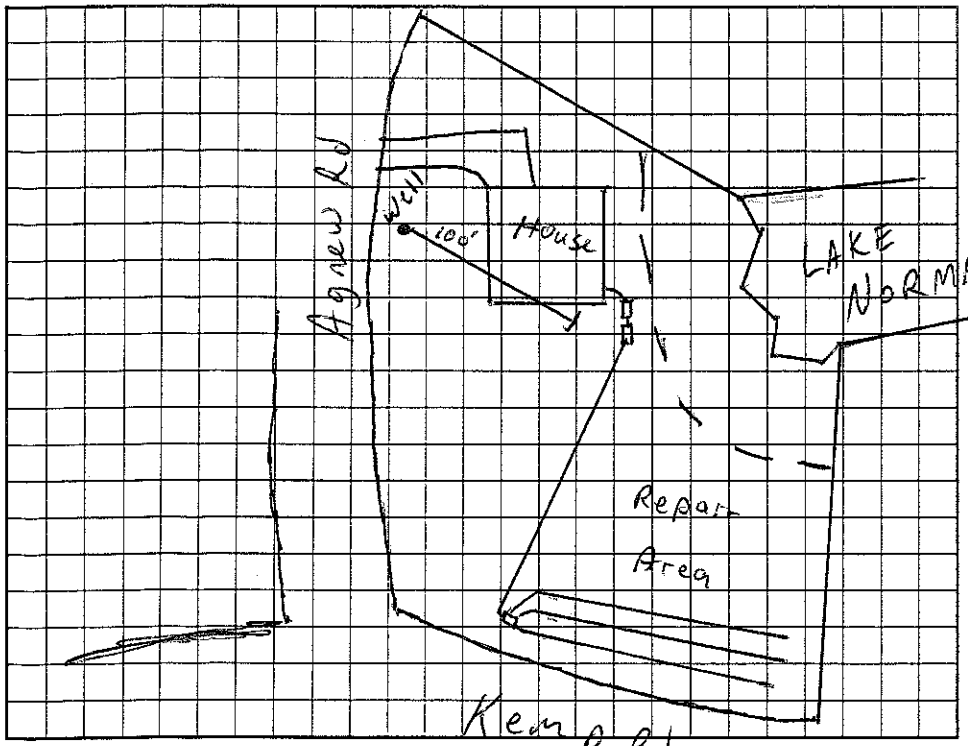

AS BUILT SKETCH

Permit can be suspended or revoked if any false information is supplied toward securing the permit/any unauthorized changes are made to the site/any unauthorized changes are made in the installation of the system. Improvement Permit with plat valid without expiration. Improvement Permit with site plan valid for sixty months. Authorization to Construct is valid for a period equal to that of Improvement Permit – not to exceed sixty months.

Signed: _____ date 6/28/02 Installed by: Hawkins

Improvement Permit by: _____ RS date 6/21/02 Operation Permit by: _____ RS date 10/4/05

Authorization to Construct by: _____ RS date 6/21/02 Existing System Inspection by: _____ date _____

HEALTH DEPT. COPY: WHITE OWNER COPY (FINAL): YELLOW OWNER COPY (INITIAL): PINK