# IREDELL COUNTY HEALTH DEPARTMENT

STATESVILLE 704-878-5305 MOORESVILLE 704-664-5281

## IMPROVEMENT PERMIT / AUTHORIZATION TO CONSTRUCT / OPERATION PERMIT / EXISTING SYSTEM INSPECTION

PERMIT# 118620 PIN# ~~4626384001.325~~ 4626373839 DATE 5/21/04

OWNER OR CONTRACTOR THE FARMS LLC (Courtlan Prop. PHONE: Business 660-1185 Home

ADDRESS 2214 BRAWLEY SCHOOL RD. MOORESVILLE NC 28115

LOCATION BRAWLEY SCHOOL - JR McKENDREE - TL KEMP - TR ALDER SPRINGS - ON RT

SUBDIVISION THE FARMS BLOCK / SECTION 3 LOT 325 LOT AREA .994AC SITE CLASS. RS DESIGN FLOW 480GPD L.T.A.R. .3gpd/ft2

Septic Tank: 1500 Gallons; STB 383 Date 9/28/05
Pump Tank: 1000 Gallons; PT 29 Date 9/28/05
Pump Make: MYERS Model ME-50 Serial No.
Nitrification Field: No Fields 1 Square Feet 1200 Linear Feet 400
No Lines 5@80' Trench Width 36" Max Trench Bottom Depth 36" Gravel Depth N/A

☑ New System ☐ Repair System Type: I, II, III, IV, V, VI
System Description: PUMP 25% REDUCTION
Repair System Description: LP PANEL
Maintenance Agreement Required: ☐ Yes ☐ No

☑ House/Mod. Home No. Bedrooms 4
☐ Mobile Home No. Bathrooms 4
☐ Business No. Employees
☐ Other


☐ Slab ☑ Crawl Space ☑ Basement w/plumbing ☐ Basement wo/plumbing

Water Supply: ☐ Individual ☐ Public ☑ Community


Comments:/Conditions:

Comments:/Conditions: PARTIAL BASEMENT
22 FLOW CHECK VALVE

INITIAL SITE SKETCH

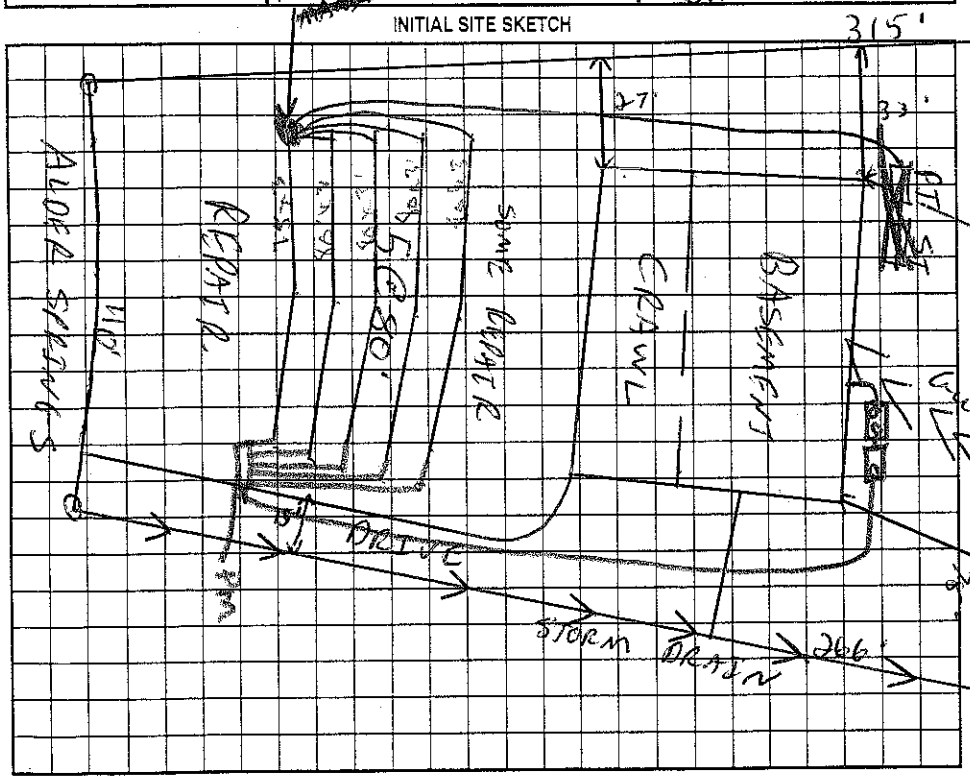


AS BUILT SKETCH

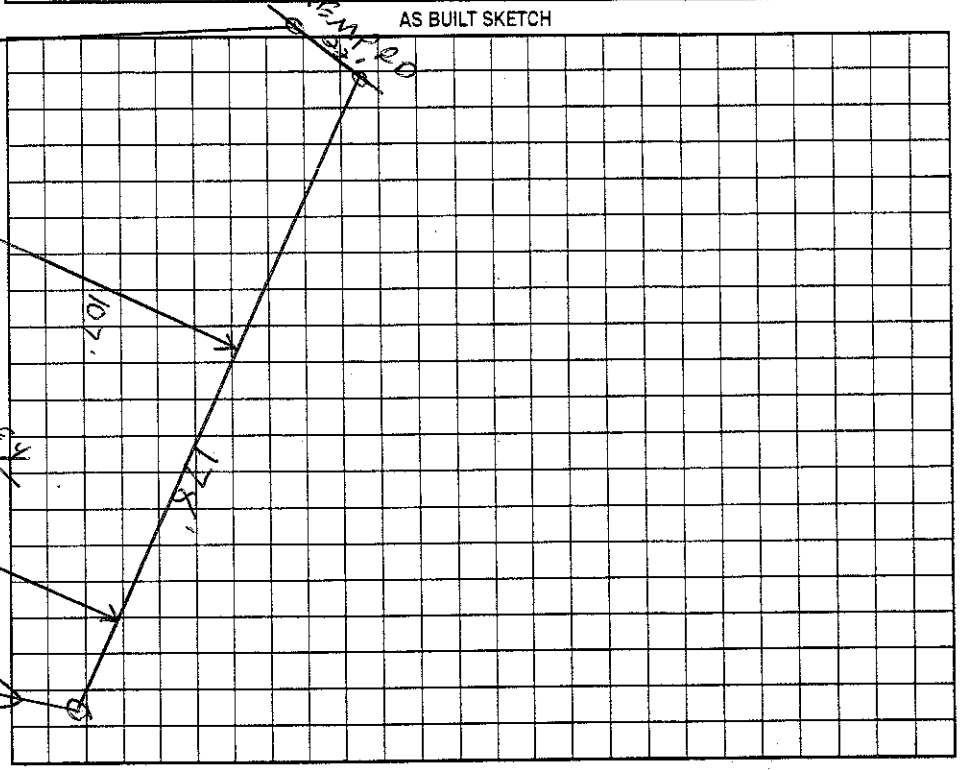


Permit can be suspended or revoked if any false information is supplied toward securing the permit/any unauthorized changes are made to the site/any unauthorized changes are made in the installation of the system. Improvement Permit with plat valid without expiration. Improvement Permit with site plan valid for sixty months. Authorization to Construct is valid for a period equal to that of Improvement Permit – not to exceed sixty months.

Signed: date 7-12-04 Installed by:

Improvement Permit by: date 5/21/04 Operation Permit by: RS date 10/7/05

Authorization to Construct by: RS date 3/14/05 Existing System Inspection by: date

HEALTH DEPT. COPY: WHITE OWNER COPY (FINAL): YELLOW OWNER COPY (INITIAL): PINK