IREDELL COUNTY HEALTH DEPARTMENT

STATESVILLE 704-878-5305 MOORESVILLE 704-664-5281

IMPROVEMENT PERMIT / AUTHORIZATION TO CONSTRUCT / OPERATION PERMIT / EXISTING SYSTEM INSPECTION

PERMIT# ~~[illegible]~~ 18701 PIN# ~~4626 38 4001.338~~ 4626-37-4106 DATE 6/1/04

OWNER OR CONTRACTOR THE FARMS LLC / LK Norman Signature PHONE: Business 660-1185 Home

ADDRESS 7714 BRAWLEY SCHOOL - TR ~~CROSS~~ MOORES VALLEE NC 28115

LOCATION BRAWLEY SCHOOL - TR MCKENDREE - TL KEMP - TR ALOFT SPRINGS - TL BAYBERRY - ON RT.

SUBDIVISION THE FARMS BLOCK / SECTION 3 LOT 338 LOT AREA .76AC SITE CLASS PS DESIGN FLOW 450GPD L.T.A.R. .3640/FT²

Septic Tank: ~~1000~~ 1500 Gallons; STB 338 Date 12/5/05
Pump Tank: 1000 Gallons; PT 243 Date 11/1/05
Pump Make: Goulds Model WE0512HHU Serial No. K0577192
Nitrification Field: No Fields 1 Square Feet 560 Linear Feet 280
No Lines 4@70' Trench Width 24" Max Trench Bottom Depth 36" Gravel Depth N/A

☑ New System ☐ Repair System Type: I, II, III, (IV), V, VI
System Description: LP PANEL
Repair System Description: SAME
Maintenance Agreement Required: ☑ Yes ☐ No

☑ House/Mod. Home No. Bedrooms 4
☐ Mobile Home No. Bathrooms 4
☐ Business No. Employees
☐ Other


☐ Slab ☑ Crawl Space ☐ Basement w/plumbing ☐ Basement wo/plumbing

Water Supply: ☐ Individual ☐ Public ☑ Community


Comments:/Conditions: Reviewed Building plans & Site plan; essentially in Compliance with I.P.

Comments:/Conditions:

INITIAL SITE SKETCH 1"=50'

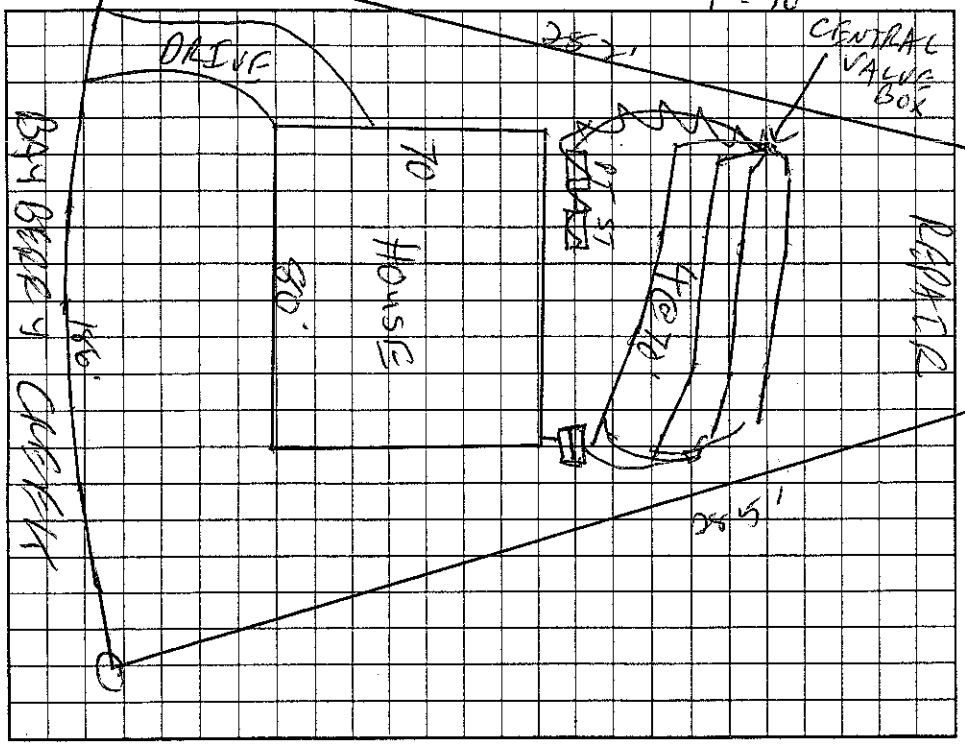

AS BUILT SKETCH

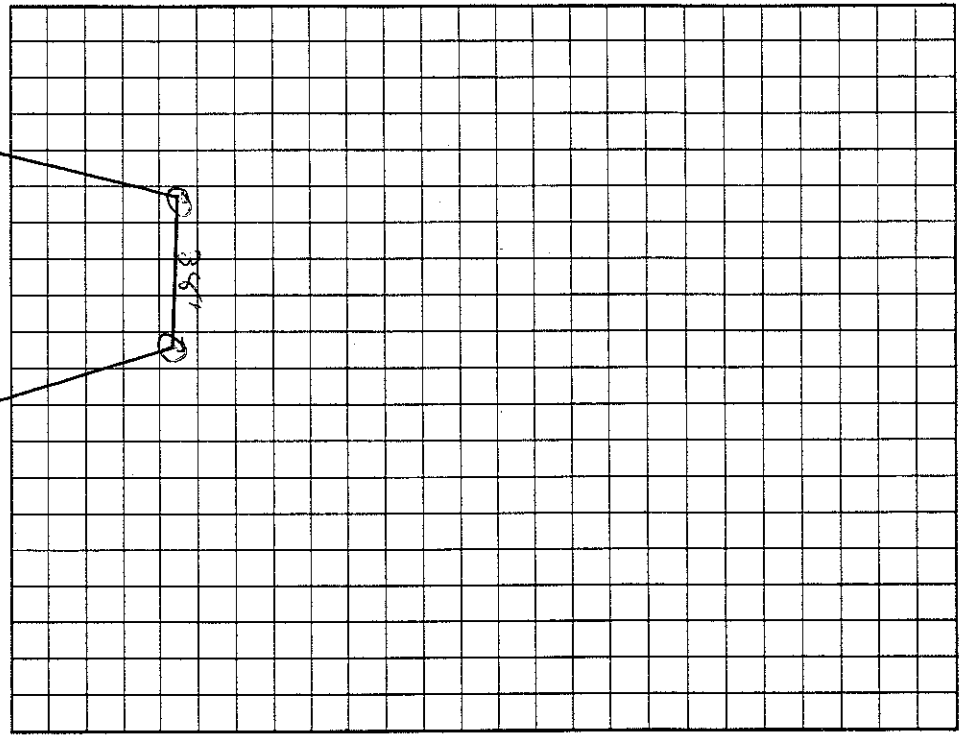

Permit can be suspended or revoked if any false information is supplied toward securing the permit/any unauthorized changes are made to the site/any unauthorized changes are made in the installation of the system. Improvement Permit with ~~plat~~ valid ~~without expiration~~. Improvement Permit with site plan valid for sixty months. Authorization to Construct is valid for a period equal to that of Improvement Permit – not to exceed sixty months.

Signed: [signature] date 7-12-04 Installed by: Hallman Const.

Improvement Permit by: [signature] date 6/1/04 Operation Permit by: [signature] RS date 3/17/06

Authorization to Construct by: [signature] RS date 7/1/05 Existing System Inspection by: date

HEALTH DEPT. COPY: WHITE OWNER COPY (FINAL): YELLOW OWNER COPY (INITIAL): PINK