IREDELL COUNTY HEALTH DEPARTMENT

Statesville Office (704) 878-5305 Mooresville Office (704) 660-3625 PERMIT # 11815

IMPROVEMENT PERMIT / AUTHORIZATION TO CONSTRUCT / OPERATION PERMIT / EXISTING SYSTEM

PIN # 4626 37 9869

APPLICANT: KGG BUILDERS APPLICANT ADDRESS: 145 WATERVIEW DR. MOORESVILLE NC 28117

SITE ADDRESS: 132 ALDER SPRINGS LN MOORESVILLE PHONE: ALT. PHONE: 892-0015

SITE DIRECTIONS: BRAWLEY SCHOOL - TR MCKENDREE - TL HEMP - TR ALDER SPRINGS -

SUBDIVISION: FARMS SECTION: 3 LOT # 324 LOT AREA: .812AC DESIGN FLOW: 600 L.T.A.R.: .3


Septic Tank	1500 (gal)	STB 390	Date 4-23	☑ New System	☐ Repair	☐ Expansion	System Type: I II (III) IV V VI	☑ Residence	No. Bedrooms	5	Water Supply
Pump Tank	0 (gal)	PT	Date	System Description:	GRAVITY 25% REDUCTION			☐ Business	No. Persons	10	☐ Private
Pump Make		Model	Serial #	Repair System Description:	LP PUMPS			☐ Other	No. Employees		☐ Public
# Nitrification Fields	1	# Lines 5	Linear Ft: 500	Maintenance Agreement Required:	☐ YES	☑ NO		☐ Slab	☑ Crawl Space		☑ Community
Trench Width	36"	Max. Trench Bottom Depth 36"	Gravel Depth —		☑ GRAVITY	☐ PRESSURE		☐ Basement w/plumbing		☐ Basement w/o plumbing	

Comments / Conditions:

INITIAL SITE SKETCH

SEE KATHLEEN SAUNDERS PLAN

AS BUILT SKETCH

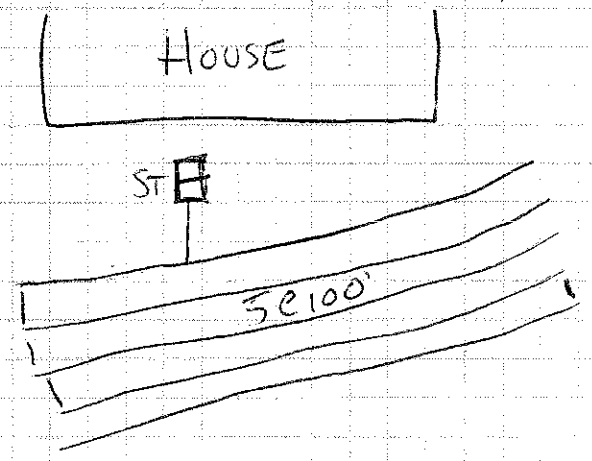

Permit can be suspended or revoked if any false information is supplied toward securing the permit / any unauthorized changes are made to the site / any unauthorized changes are made in the installation of the system. **CONTACT A LOCATOR SERVICE PRIOR TO ANY EXCAVATION**

☐ **IMPROVEMENT PERMIT** *with plat valid without expiration.* ☑ **IMPROVEMENT PERMIT** *with site plan valid for 60 mos.* ☑ **AUTHORIZATION TO CONSTRUCT** *valid for period equal to IMPROVEMENT PERMIT--not to exceed 60 mo.*

Owner / Applicant Signature: Kathleen Saunders Date: 7/17/13 Installed by: A-1 BACKHOE

IMPROVEMENT PERMIT by: C. [illegible] REHS Date: 7/17/13 OPERATION PERMIT by: [illegible] Date: 10-29-13

AUTHORIZATION TO CONSTRUCT by: C. [illegible] EHS Date: 7/17/13 Existing System Inspected by: Date:

Health Dept. Copy - WHITE Applicant (Final Approval) - YELLOW Applicant (Conditional Approval) - PINK