IREDELL COUNTY HEALTH DEPARTMENT

STATESVILLE 704-878-5305 MOORESVILLE 704-664-5281

IMPROVEMENT PERMIT / AUTHORIZATION TO CONSTRUCT / OPERATION PERMIT / EXISTING SYSTEM INSPECTION

PERMIT # 153387 PIN # 4626 39 5326 DATE 11/3/08

OWNER or APPLICANT DAVID GILLILAND PHONE: Business 704-202-7974 Home:

OWNER or APPLICANT ADDRESS 288 BAYBERRY CRK. DR. MOORESVILLE, NC. 28117

LOCATION / DIRECTIONS 1100 TR MCKONDREE TL KEMP TR ALDER SPRINGS TL BAYBERRY CREEK, 2ND HOUSE ON R

SUBDIVISION FARMS BLOCK / SECTION 3 LOT # 336 LOT AREA 2.74 DESIGN FLOW 600 L.T.A.R. .3

Septic Tank EXIST. Gallons: STB Date

Pump Tank EXIST. Gallons: P.T Date

Pump Make Model Serial #

Nitrification Field No Fields 1 No Lines 4 Linear Feet 500

Trench Width 3 Max. Trench Bottom Depth Gravel Depth

☐ New System ☐ Repair ☐ Expansion System Type I II (III) IV V VI

System Description: 36 - EXISTING SYSTEM

Repair System Description: IV - LP PPBPS

Maintenance Agreement Required ☐ YES ☒ NO

☐ GRAVITY ☒ PRESSURE

☒ Residence No. Bedrooms 5

☐ Business No. Persons

☐ Other No. Employees

☐ Slab ☒ Crawl Space


☐ Basement w/plumbing ☐ Basement w/o plumbing

Water Supply: ☐ Private ☐ Public ☒ Community


Comments / Conditions

Comments / Conditions NEW DECK TO BE ENCLOSED.

INITIAL SITE SKETCH

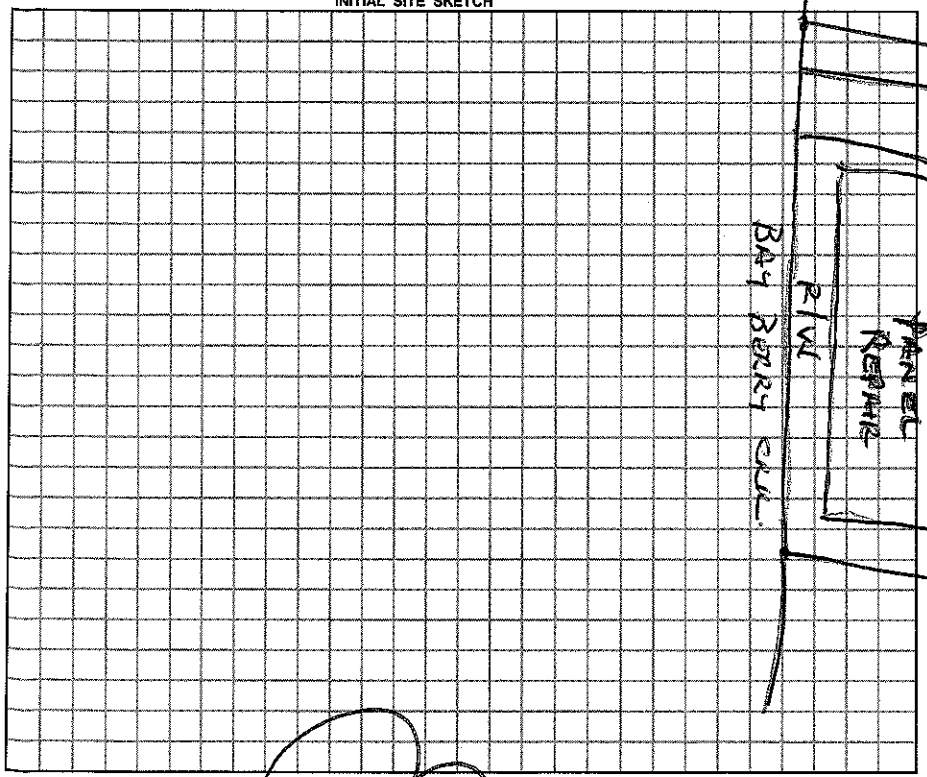

AS BUILT SKETCH

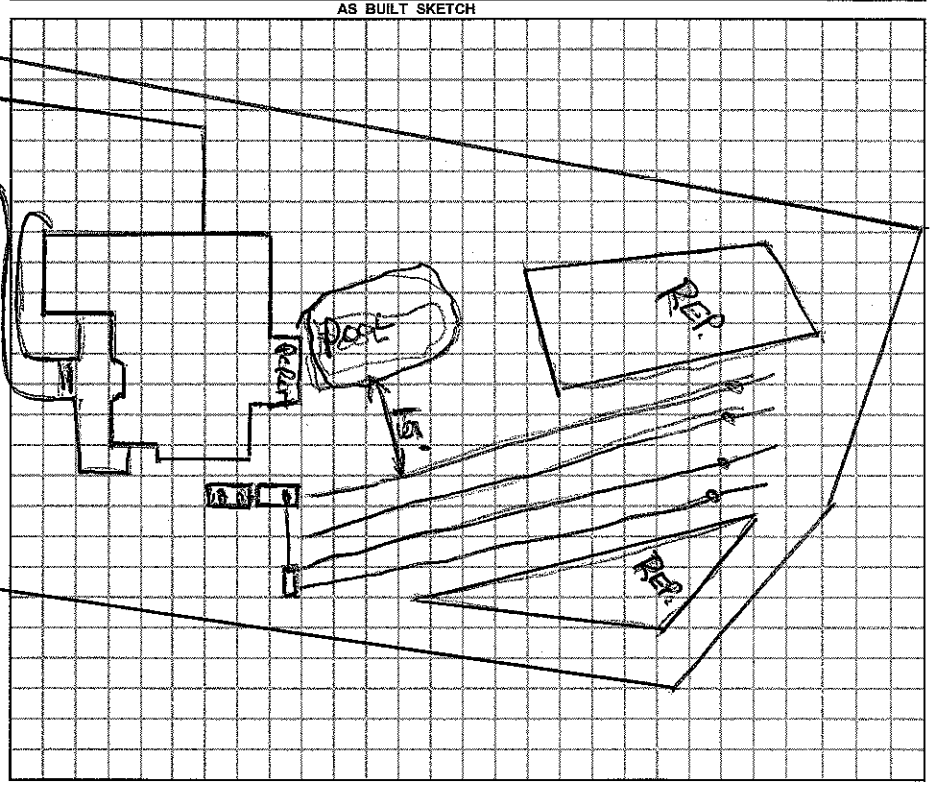

Permit can be suspended or revoked if any false information is supplied toward securing the permit / any unauthorized changes are made to the site / any unauthorized changes are made in the installation of the system.

☐ *IMPROVEMENT PERMIT w/ plat valid without expiration* ☐ *IMPROVEMENT PERMIT w / site plan valid for 60 mos.* ☐ *AUTHORIZATION TO CONSTRUCT valid for period equal to IMPROVEMENT PERMIT-not to exceed 60 mo.*

Owner / Applicant Signature: Date 11/4/08

Improvement Permit by: Date

Authorization to Construct by: Date

YOU SHOULD CONTACT A LOCATOR SERVICE PRIOR TO ANY EXCAVATION.

Installed by:

Operation Permit by: Date:

Existing System Inspected by: Wendy Sparks R.S. Date: 11/3/08

WHITE COPY Environmental Health YELLOW COPY (Final) Owner / Applicant PINK COPY (Initial) Owner / Applicant