4626376524

IREDELL COUNTY HEALTH DEPARTMENT

STATESVILLE 704-878-5305 MOORESVILLE 704-664-5281

IMPROVEMENT PERMIT / AUTHORIZATION TO CONSTRUCT / OPERATION PERMIT / EXISTING SYSTEM INSPECTION

PERMIT# 118696 PIN# ~~4626 38 4001 335~~ ~~4626376544~~ DATE 5/24/04

OWNER OR CONTRACTOR THE FARMS / Strom Coast, Inc PHONE: Business 660-1185 Home

ADDRESS 2214 BRAWLEY SCHOOL RD- MOORESVILLE NC 28115 121 Alder Springs Ln

LOCATION BRAWLEY SCHOOL - TR McKENDREE - TL KEMP - TR ALDER SPRINGS - JUST PAST BAYBERRY - ON LT CORNER

SUBDIVISION THE FARMS BLOCK / SECTION 3 LOT 335 LOT AREA .81AC SITE CLASS. PS DESIGN FLOW 450GPD L.T.A.R. .36GPD/FT²

Septic Tank: 1000 Gallons; STB Date

Pump Tank: Gallons; PT Date

Pump Make: Model Serial No.

Nitrification Field: No Fields 1 Square Feet 1200 Linear Feet 400

No Lines 4@100' Trench Width 36" Max Trench Bottom Depth 36" Gravel Depth N/A

☑ New System ☐ Repair System Type: I, II, III, IV, V, VI

System Description: GRAVITY 25% REDUCTION

Repair System Description: LP PANEL

Maintenance Agreement Required: ☐ Yes ☑ No

☑ House/Mod. Home No. Bedrooms 4

☐ Mobile Home No. Bathrooms 4

☐ Business No. Employees

☐ Other

☐ Slab ☑ Crawl Space ☐ Basement w/plumbing ☐ Basement wo/plumbing


Water Supply: ☐ Individual ☐ Public ☑ Community

Comments:/Conditions:


Drain field will need to be shifted down to have room for the Garage

Comments:/Conditions:

INITIAL SITE SKETCH 1"=50'

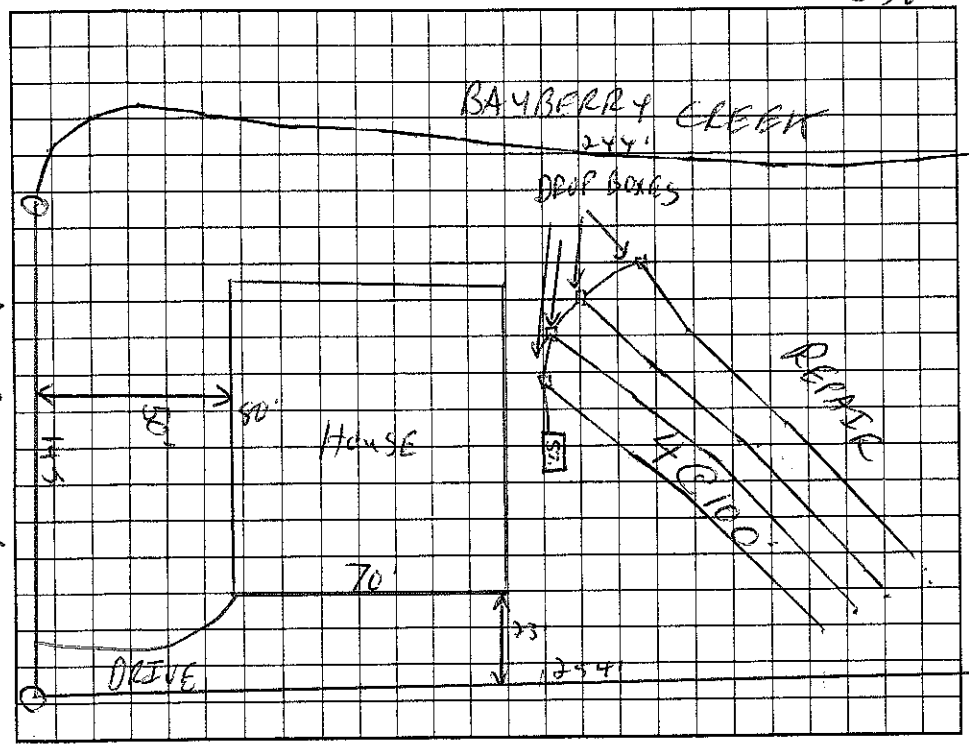

AS BUILT SKETCH

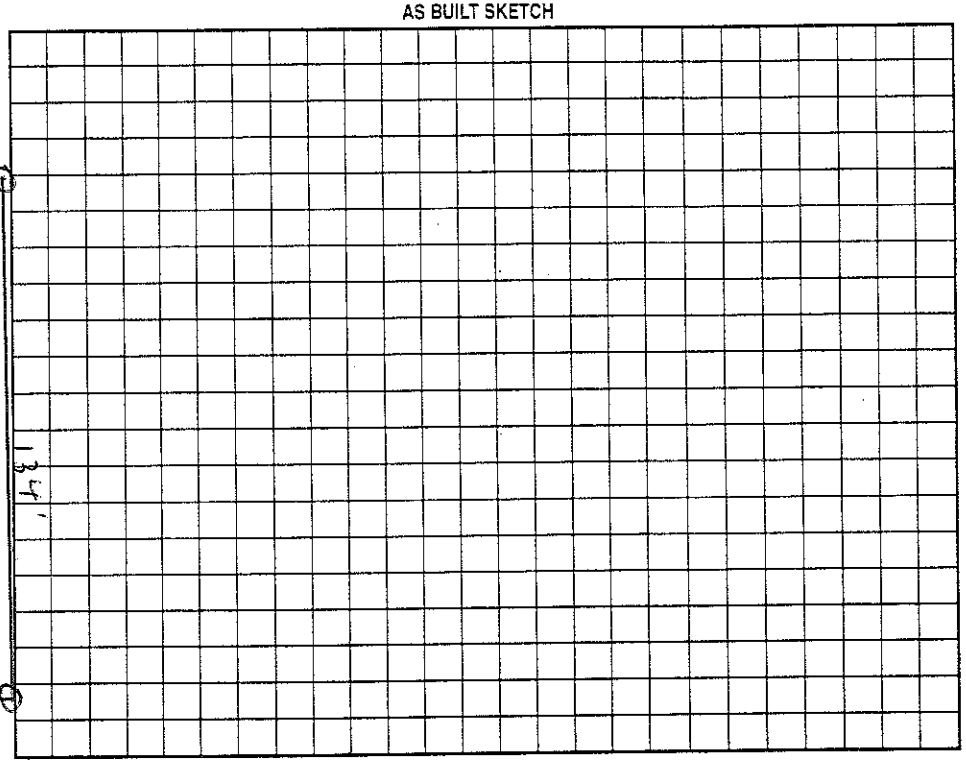

Permit can be suspended or revoked if any false information is supplied toward securing the permit/any unauthorized changes are made to the site/any unauthorized changes are made in the installation of the system. Improvement Permit with plat valid without expiration. Improvement Permit with site plan valid for sixty months. Authorization to Construct is valid for a period equal to that of Improvement Permit – not to exceed sixty months.

Signed: date 7-12-04 Installed by: Stanley Septic

Improvement Permit by: RS date 5/24/04 Operation Permit by: Wesley Sparks date 12-28-05

Authorization to Construct by: RS date 6/16/05 Existing System Inspection by: date

HEALTH DEPT. COPY: WHITE OWNER COPY (FINAL): YELLOW OWNER COPY (INITIAL): PINK