4626376807

IREDELL COUNTY HEALTH DEPARTMENT

STATESVILLE 704-878-5305 MOORESVILLE 704-664-5281

IMPROVEMENT PERMIT / AUTHORIZATION TO CONSTRUCT / OPERATION PERMIT / EXISTING SYSTEM INSPECTION

PERMIT# 11861 PIN# 4626 38 4001 DATE 1-11-06

OWNER OR APPLICANT David S. Rushing PHONE: Business 704-896-5766 Home 704-361-5440 mobile

ADDRESS Brawley school Rd, TR McKendree TL Kemp TR Alder Springs on right

LOCATION 221 Beracah Rd Mooresville 28115

SUBDIVISION The Farms BLOCK / SECTION Ph 3 LOT 323 LOT AREA .8 Ac SITE CLASS. PS DESIGN FLOW 480gpd L.T.A.R. .3 gpd/ft²

1500 as built

Septic Tank: 1000 Gallons; STB 338 Date 11-15-06

Pump Tank: _____ Gallons; PT _____ Date _____

Pump Make: _____ Model _____ Serial No. _____

Nitrification Field: No Fields 1 Square Feet 1200 Linear Feet 400

No Lines 4@100' Trench Width 36" Max Trench Bottom Depth 36" Gravel Depth N/A

☒ New System ☐ Repair ☐ Expansion System Type: I II III IV V VI

System Description: 25% reduction, gravity

Repair System Description: 25% reduction, gravity

Maintenance Agreement Required: ☐ Yes ☒ No LP Panel

☒ Gravity ☐ Pressure

☒ House/Mod. Home ☐ Mobile Home ☐ Business ☐ Other

No. Bedrooms 4 No. Persons ____ No. Employees ____

Water Supply: ☐ Individual ☐ Public ☒ Community


☐ Slab ☐ Crawl Space ☒ Basement w/plumbing ☐ Basement wo/plumbing

Comments:/Conditions:


Comments:/Conditions:

5T w/ risers
Installed Quick 4 infiltrator
changed to LP Panel Repair

INITIAL SITE SKETCH

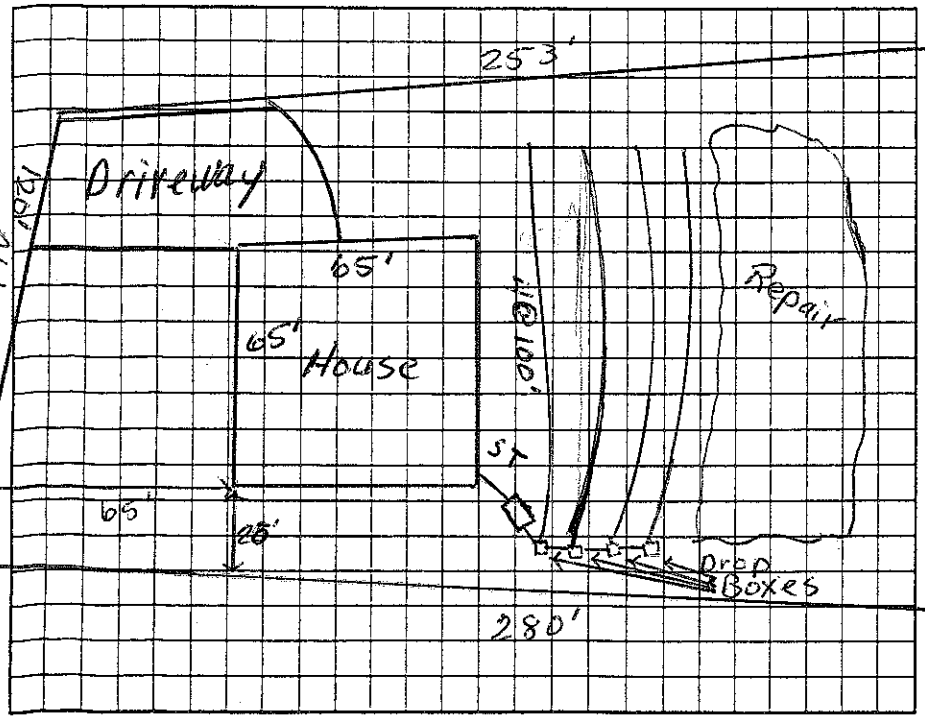

AS BUILT SKETCH

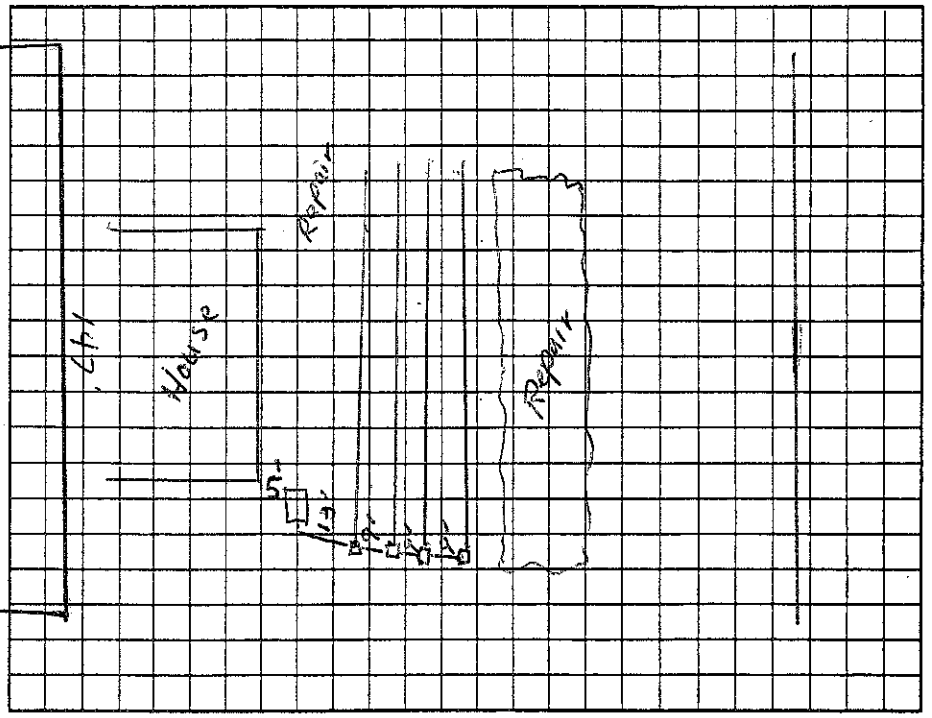

Permit can be suspended or revoked if any false information is supplied toward securing the permit/any unauthorized changes are made to the site/any unauthorized changes are made in the installation of the system. Improvement Permit with plat valid without expiration ☐ Improvement Permit with site plan valid for sixty months ☒ Authorization to Construct is valid for a period equal to that of Improvement Permit – not to exceed sixty months.

Signed: D Rushing date 1-13-06

Improvement Permit by: Judy Melville date 1-11-06

Authorization to Construct by: Judy Melville date 7-18-06

Installed by: Mr Carver Construction

Operation Permit by: Judy Melville date 12-20-06

Existing System Inspection by: _____ date _____

HEALTH DEPT. COPY: WHITE OWNER COPY (FINAL): YELLOW OWNER COPY (INITIAL): PINK