IREDELL COUNTY HEALTH DEPARTMENT

STATESVILLE 704-878-5305 MOORESVILLE 704-664-5281

IMPROVEMENT PERMIT / AUTHORIZATION TO CONSTRUCT / OPERATION PERMIT / EXISTING SYSTEM INSPECTION

PERMIT# 11902 PIN# ~~4625-50-5104.384~~ 4626-37-7283. DATE 2/21/05

OWNER OR CONTRACTOR JS TESTA PHONE: Business 704-892-2995 Home

ADDRESS

LOCATION Bayberry Circle, 1100 TR McKendree TL Kemp TR Alden Springs TL Bayberry on (L)

SUBDIVISION Farms BLOCK / SECTION 3 LOT 384 LOT AREA .78AC SITE CLASS. PS DESIGN FLOW 480 L.T.A.R. .3

Septic Tank: ~~1000~~ 1500 Gallons; STB 338 Date 10/1/05

Pump Tank: 1000 Gallons; PT 253 Date 9/21/05

Pump Make: DOULAS Model WPE-3 1/2 Serial No. 10/05

Nitrification Field: No Fields 1 Square Feet 540/810 Linear Feet 270

No Lines 3 @ 90' Trench Width 2-3' Max Trench Bottom Depth 3' Gravel Depth N/A

☒ New System ☐ Repair System Type: I, II, III, (IV), V, VI

System Description: Pres Dosed - 16" PPBPS

Repair System Description: SAME

Maintenance Agreement Required: ☒ Yes ☐ No

☒ House/Mod. Home No. Bedrooms 4

☐ Mobile Home No. Bathrooms 4

☐ Business No. Employees

☐ Other


☐ Slab ☒ Crawl Space ☐ Basement w/plumbing ☐ Basement wo/plumbing

Water Supply:
☐ Individual
☐ Public
☒ Community


Comments:/Conditions:

Comments:/Conditions: Living, Tankless

INITIAL SITE SKETCH

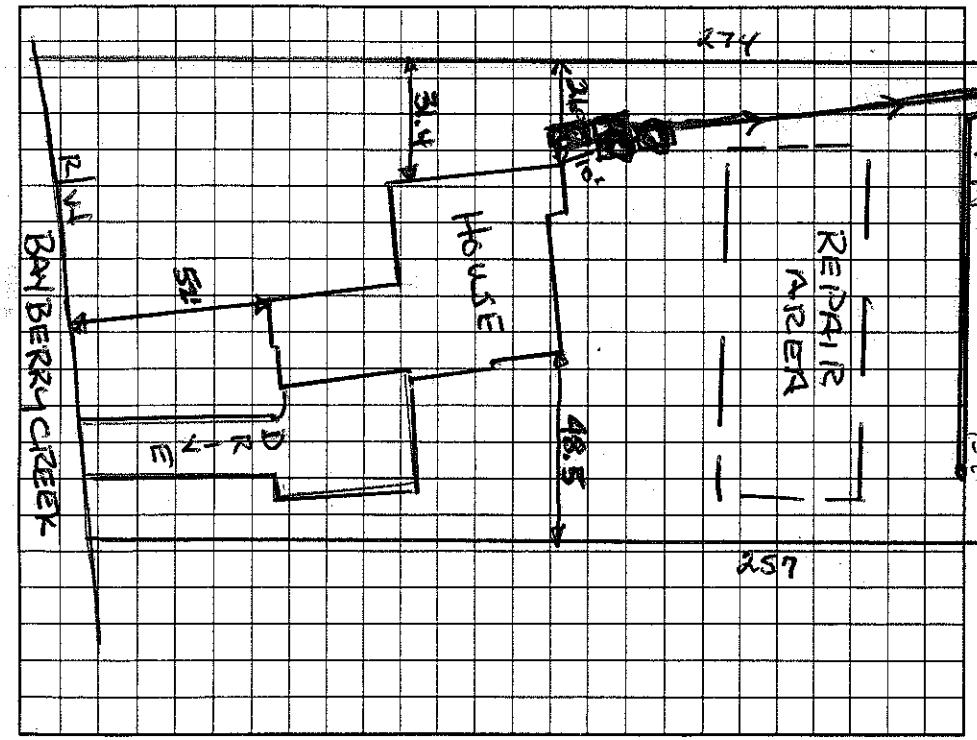

AS BUILT SKETCH

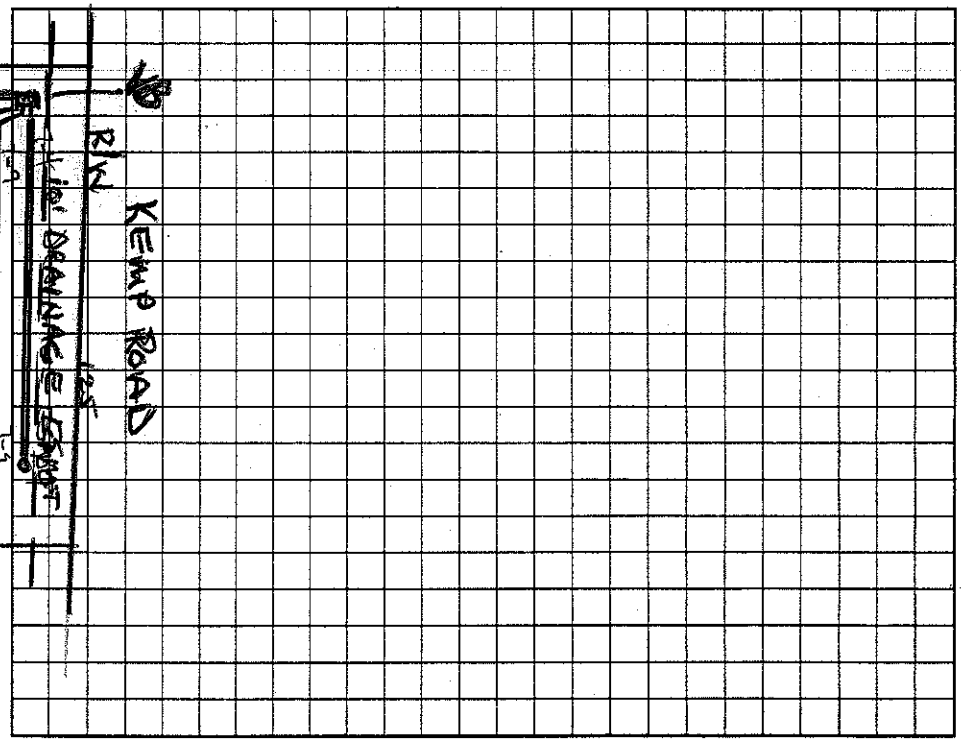

Permit can be suspended or revoked if any false information is supplied toward securing the permit/any unauthorized changes are made to the site/any unauthorized changes are made in the installation of the system. Improvement Permit with plat valid without expiration. Improvement Permit with site plan valid for sixty months. Authorization to Construct is valid for a period equal to that of Improvement Permit – not to exceed sixty months.

Signed: X [signature] date

Improvement Permit by: Wesley Sparks RS. date 2/21/05

Authorization to Construct by: Wesley Sparks RS. date 2/21/05

Installed by: Odom & Sons

Operation Permit by: Wesley Sparks RS. date 11/4/05

Existing System Inspection by: date

HEALTH DEPT. COPY: WHITE OWNER COPY (FINAL): YELLOW OWNER COPY (INITIAL): PINK