IREDELL COUNTY HEALTH DEPARTMENT

STATESVILLE 704-878-5305 MOORESVILLE 704-664-5281

IMPROVEMENT PERMIT / AUTHORIZATION TO CONSTRUCT / OPERATION PERMIT / EXISTING SYSTEM INSPECTION

PERMIT# 119504 PIN# ~~4625505104.385~~ 4626377494 DATE 6/28/04

OWNER OR CONTRACTOR THE FARMS LLC / DS Rushing Inc PHONE: Business 660-1185 Home

ADDRESS 7214 BRAWLEY SCHOOL RD - MOORESVILLE NC 28115

LOCATION BRAWLEY SCHOOL - TR McKENDREE - TL KEMP - TR ALDER SPRINGS - ON LT CORNER OF BAYBERRY

SUBDIVISION THE FARMS BLOCK / SECTION 3 LOT 385 LOT AREA .78AC SITE CLASS. PS DESIGN FLOW 480GPD L.T.A.R. - 36.50/FT²

Septic Tank: 1000 Gallons: STB 338 Date 2/7/05
Pump Tank: Gallons: PT Date
Pump Make: Model Serial No.
Nitrification Field: No Fields 1 Square Feet 1000 Linear Feet 400
No Lines 5@80' Trench Width 36" Max Trench Bottom Depth 36" Gravel Depth N/A

☑ New System ☐ Repair System Type: I, II, III, IV, V, VI
System Description: GRAVITY 25% REDUCTION LP PANEL
Repair System Description:
Maintenance Agreement Required: ☐ Yes ☑ No


☑ House/Mod. Home No. Bedrooms 4
☐ Mobile Home No. Bathrooms 4
☐ Business No. Employees
☐ Other
☐ Slab ☑ Crawl Space ☐ Basement w/plumbing ☐ Basement wo/plumbing

Water Supply:
☐ Individual
☐ Public
☑ Community

Comments:/Conditions:

Comments:/Conditions: EZFLOW INSTALLED

1"=50' INITIAL SITE SKETCH

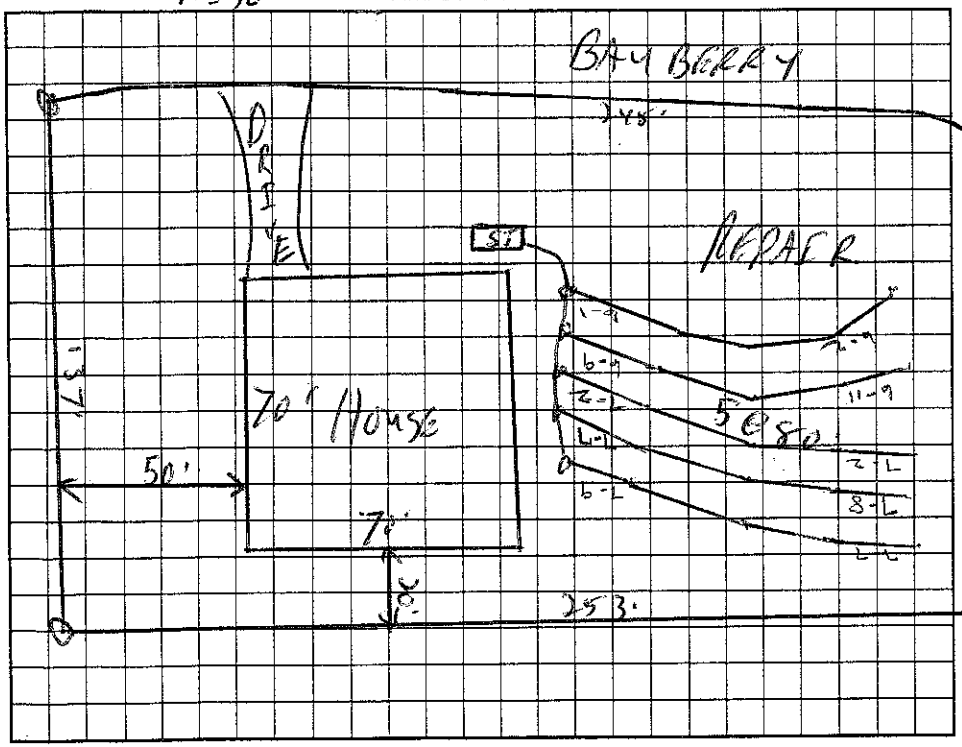

AS BUILT SKETCH

Permit can be suspended or revoked if any false information is supplied toward securing the permit/any unauthorized changes are made to the site/any unauthorized changes are made in the installation of the system. Improvement Permit with plat valid without expiration. Improvement Permit with site plan valid for sixty months. Authorization to Construct is valid for a period equal to that of Improvement Permit – not to exceed sixty months.

Signed: date 7-12-04

Improvement Permit by: date 6/28/04

Authorization to Construct by: RS date 11/4/04

Installed by: Bob McCarver

Operation Permit by: Wesley Sparks RS date 3/11/05

Existing System Inspection by: date

HEALTH DEPT. COPY: WHITE OWNER COPY (FINAL): YELLOW OWNER COPY (INITIAL): PINK