As Built

IREDELL COUNTY HEALTH DEPARTMENT

STATESVILLE 704-878-5305 MOORESVILLE 704-664-5281

IMPROVEMENT PERMIT / AUTHORIZATION TO CONSTRUCT / OPERATION PERMIT / EXISTING SYSTEM INSPECTION

PERMIT# 119634 PIN# 4625505104.431 DATE 10-11-05

OWNER OR APPLICANT The Hoke Company Inc PHONE: Business 799-7495 Home

ADDRESS P.O. Box 4448 Mooresville NC 28117

LOCATION Brawley School TR McKendree TL Bayberry on left

SUBDIVISION The Farms BLOCK / SECTION 3 LOT 431 LOT AREA 1.51 Acre SITE CLASS. P5 DESIGN FLOW 480gpd L.T.A.R. .3

Septic Tank: 1000T Gallons; STB 338 Date 11-16-05
Pump Tank: 1000 Gallons; PT 283 Date 11-16-05
Pump Make: Myers Model ME50 Serial No.
Nitrification Field: No Fields 1 Square Feet 1200 Linear Feet 400
No Lines 4 Trench Width 36" Max Trench Bottom Depth 36"

☒ New System ☐ Repair ☐ Expansion System Type: I II (III) IV V VI
System Description: Pump-25% Reduction
Repair System Description: Same
Maintenance Agreement Required: ☐ Yes ☒ No

☒ House/Mod. Home No. Bedrooms 4
☐ Mobile Home No. Persons
☐ Business No. Employees
☐ Other


Water Supply: ☐ Individual ☒ Public ☒ Community

Gravel Depth N/A ☐ Gravity ☒ Pressure ☐ Slab ☒ Crawl Space ☐ Basement w/plumbing ☐ Basement wo/plumbing

Comments:/Conditions:
Scale 1"=50'


PL 367'

INITIAL SITE SKETCH

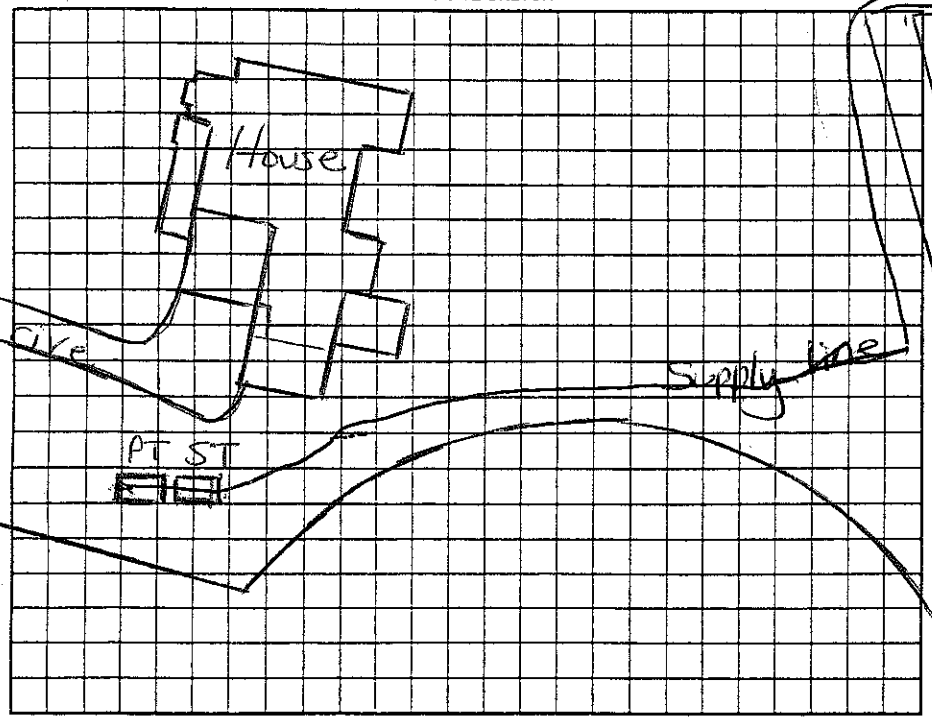

Comments:/Conditions:

AS BUILT SKETCH

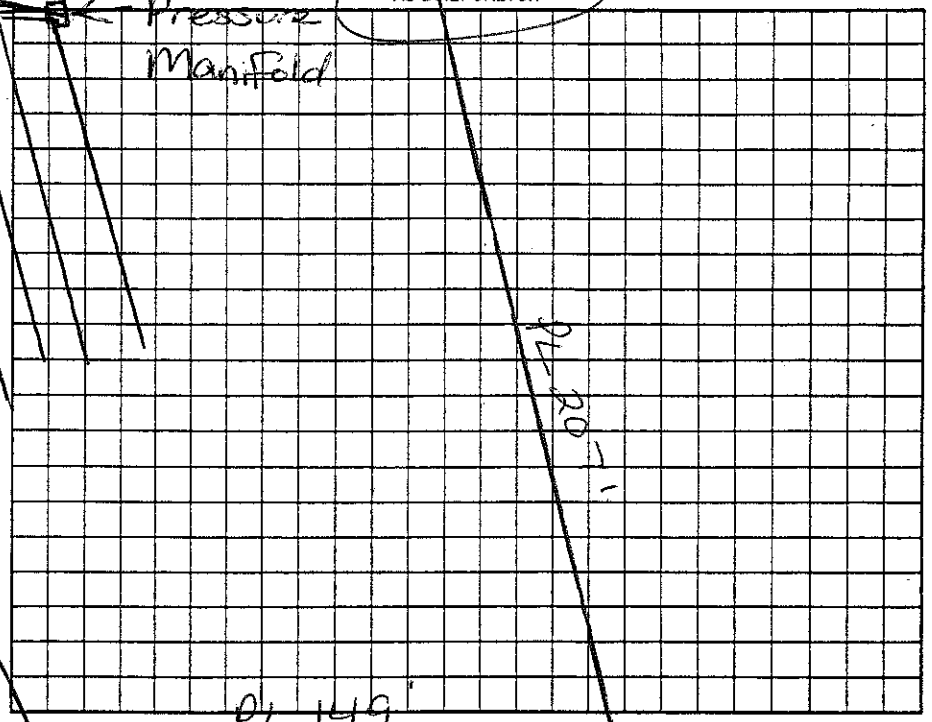

Permit can be suspended or revoked if any false information is supplied toward securing the permit/any unauthorized changes are made to the site/any unauthorized changes are made in the installation of the system. Improvement Permit with plat valid without expiration ☐ Improvement Permit with site plan valid for sixty months ☐ Authorization to Construct is valid for a period equal to that of Improvement Permit – not to exceed sixty months.

Signed: X date
Improvement Permit by: Maria H Dotson date
Authorization to Construct by: Maria H Dotson date

Installed by: R & H
Operation Permit by: Maria H Dotson RS date 3/8/06
Existing System Inspection by: date

HEALTH DEPT. COPY: WHITE OWNER COPY (FINAL): YELLOW OWNER COPY (INITIAL): PINK