4.00

IREDELL COUNTY HEALTH DEPARTMENT

STATESVILLE 704-878-5305 MOORESVILLE 704-664-5281

IMPROVEMENT PERMIT / AUTHORIZATION TO CONSTRUCT / OPERATION PERMIT / EXISTING SYSTEM INSPECTION

PERMIT# 118608 PIN# 4626384001.320 4626-38-2330 DATE 4/4/08

OWNER OR APPLICANT Jasper Builders PHONE: Business 704-799-9982 Home

ADDRESS 804 N Main St. Mooresville, NC

LOCATION Brawley School Rd. TR McKendree, TL Bayberry, on RT

SUBDIVISION The Farms BLOCK / SECTION 3 LOT 320 LOT AREA 1.11 acre SITE CLASS P.S. DESIGN FLOW 480 gpd L.T.A.R. 0.25

Septic Tank: 1000 Gallons: STB 335 Date 8-26-05
Pump Tank: 1000 Gallons: PT 27 Date 1-25-08
Pump Make: Gouldes Model LVF0312HSP1U Serial No.
Nitrification Field: No Fields 1 Square Feet 1440 Linear Feet 480
No Lines 4x120' Trench Width 36" Max Trench Bottom Depth 24"

☑ New System ☐ Repair ☐ Expansion System Type: I II (III) IV V VI
System Description: Pump - 25% Reduction
Repair System Description: LP Panel Block
Maintenance Agreement Required: ☐ Yes ☒ No not initially
Gravel Depth N/A ☐ Gravity ☑ Pressure


☑ House/Mod. Home ☐ Mobile Home ☐ Business ☐ Other
No. Bedrooms 4 No. Persons No. Employees

Water Supply: ☐ Individual ☑ Public ☑ Community

☐ Slab ☑ Crawl Space ☐ Basement w/plumbing ☐ Basement wo/plumbing


Comments:/Conditions: X Do not cut House site

INITIAL SITE SKETCH Scale 1"=50'

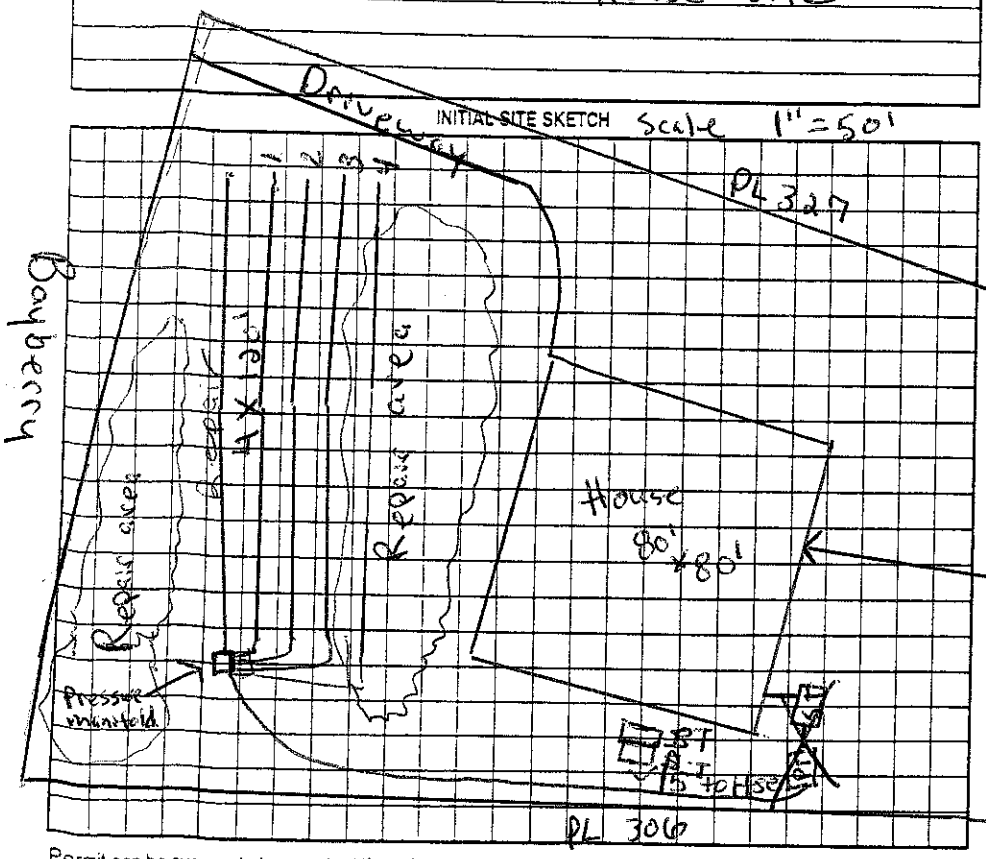

Comments:/Conditions: 11/19/08 Checked Tanks & lines (line closest to house 4ft short due to driveway) Note: Initial system a little closer to house than original permit

AS BUILT SKETCH

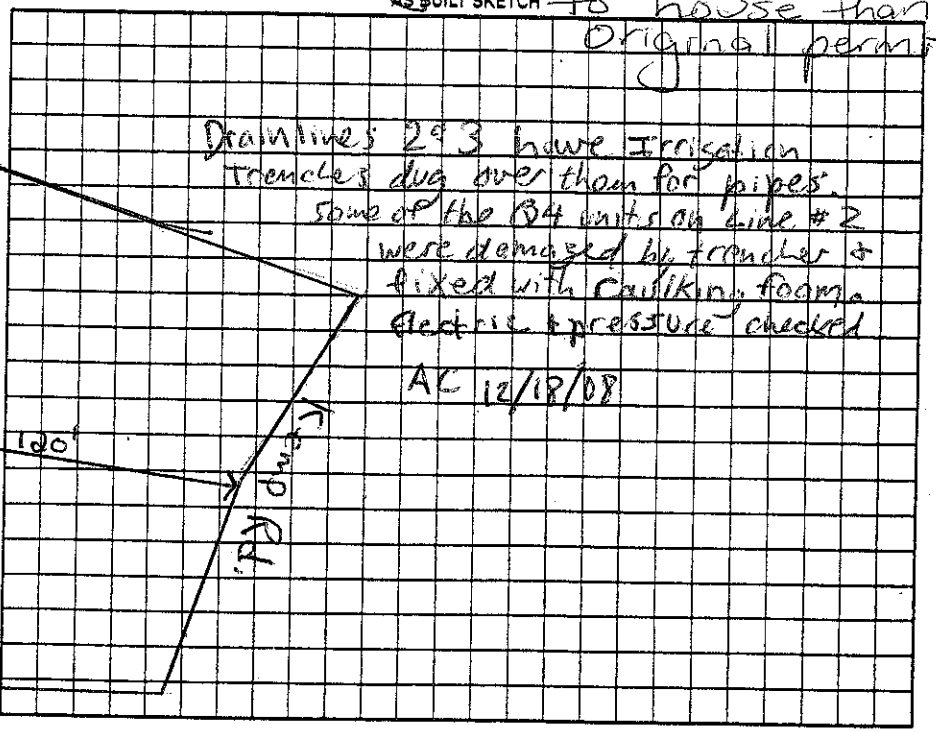

Permit can be suspended or revoked if any false information is supplied toward securing the permit/any unauthorized changes are made to the site/any unauthorized changes are made in the installation of the system. Improvement Permit with plat valid without expiration ☐ Improvement Permit with site plan valid for sixty months ☑ Authorization to Construct is valid for a period equal to that of Improvement Permit – not to exceed sixty months.

Signed: Terri Crawley date 4-7-08

Improvement Permit by: Rally Moore date 4/4/08

Authorization to Construct by: Rally Moore date 4/4/08

Installed by: Richard Abernathy

Operation Permit by: Anthony Sloan R.S. date 12/18/08

Existing System Inspection by: date

HEALTH DEPT. COPY: WHITE OWNER COPY (FINAL): YELLOW OWNER COPY (INITIAL): PINK