IREDELL COUNTY HEALTH DEPARTMENT

STATESVILLE 704-878-5305 MOORESVILLE 704-664-5281

130

IMPROVEMENT PERMIT / AUTHORIZATION TO CONSTRUCT / OPERATION PERMIT / EXISTING SYSTEM INSPECTION

PERMIT# 119620 PIN# ~~4625505104.420~~ 4626386403.000

OWNER OR CONTRACTOR THE FARMS LLC / ES Johnson DATE 2/24/05

ADDRESS 2214 BRAWLEY SCHOOL RD MOORESVILLE PHONE: Business Home

LOCATION BRAWLEY SCHOOL - TR McKENDREE - TC BRADSHAW - ON LT

SUBDIVISION THE FARMS BLOCK / SECTION 3 LOT 400 LOT AREA 1.12AC SITE CLASS. PS DESIGN FLOW 480GPD L.T.A.R. .25GPD/SQ FT

Septic Tank: 1000 Gallons; STB 338 Date 1-12-06

Pump Tank: 1000 Gallons; PT 27 Date 6-5-06

Pump Make: Myers Model ME100 Serial No.

Nitrification Field: No. Fields 1 Square Feet 1440 Linear Feet 480

No Lines 4@120' Trench Width 36" Max Trench Bottom Depth 36" Gravel Depth N/A

☑ New System ☐ Repair System Type: I, II, III, IV, V, VI

System Description: Pump 2596 REDUCTION OFFSITE

Repair System Description: SAME OFFSITE

Maintenance Agreement Required: ☐ Yes ☑ No

☑ House/Mod. Home No. Bedrooms 4

☐ Mobile Home No. Bathrooms 4

☐ Business No. Employees

☐ Other

☐ Slab ☑ Crawl Space ☐ Basement w/plumbing ☐ Basement wo/plumbing


Water Supply: ☐ Individual ☐ Public ☑ Community

Comments:/Conditions: SEE PLAT FOR OFFSITE SUPPLY LINE LOCATION


Renewed plans 1/10/06. essentially in Compliance with original permit

Comments/Conditions: 7/7/06 Installed Quick 4 as Drawn Checked tanks 7/7/06 MD

INITIAL SITE SKETCH 1"=50'

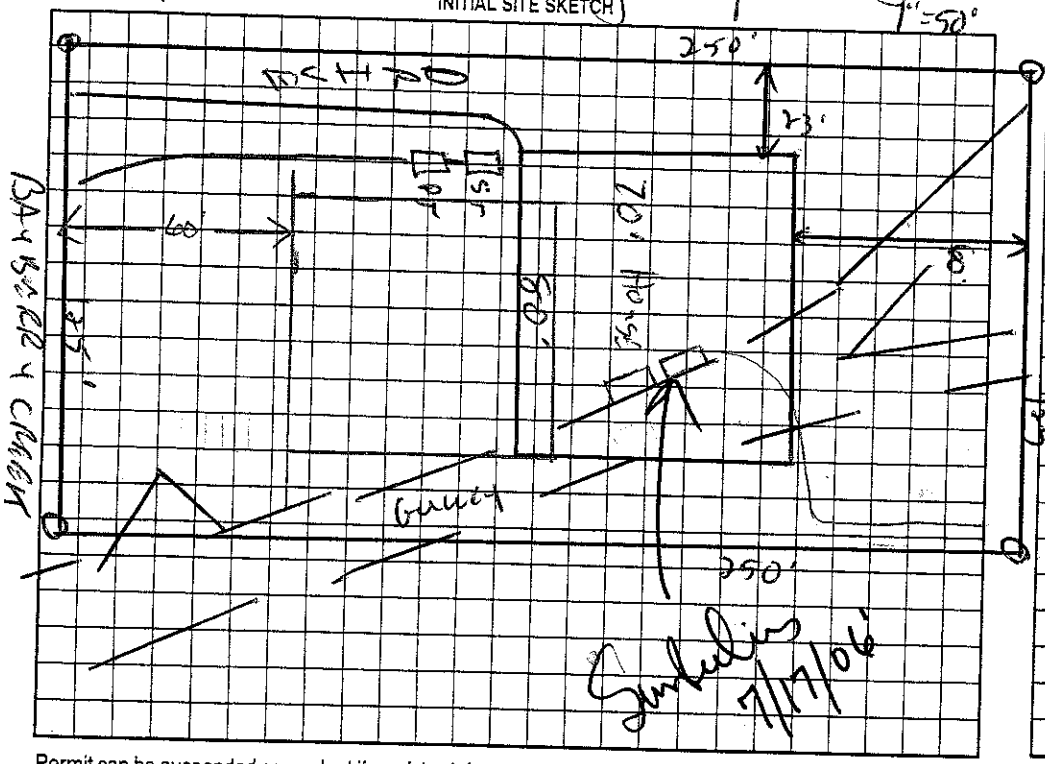

AS BUILT SKETCH

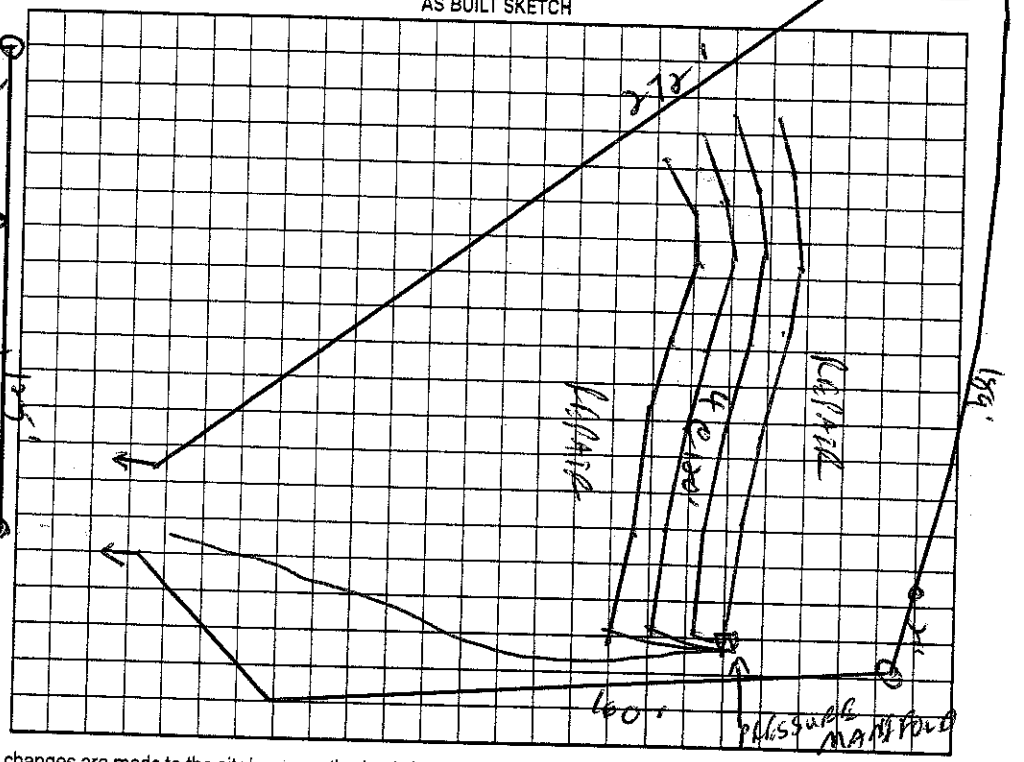

Permit can be suspended or revoked if any false information is supplied toward securing the permit/any unauthorized changes are made to the site/any unauthorized changes are made in the installation of the system. Improvement Permit with plat valid without expiration. Improvement Permit with site plan valid for sixty months. Authorization to Construct is valid for a period equal to that of Improvement Permit – not to exceed sixty months.

Signed: date 2-24-05 Installed by: Willie Christenbury

Improvement Permit by: date 2/24/05 Operation Permit by: date 9/8/06

Authorization to Construct by: date 1/10/06 Existing System Inspection by: date

HEALTH DEPT. COPY: WHITE OWNER COPY (FINAL): YELLOW OWNER COPY (INITIAL): PINK