IREDELL COUNTY HEALTH DEPARTMENT

STATESVILLE 704-878-5305 MOORESVILLE 704-664-5281

IMPROVEMENT PERMIT / AUTHORIZATION TO CONSTRUCT / OPERATION PERMIT / EXISTING SYSTEM INSPECTIO

1:30-2:00 1:30

PERMIT# 119618 PIN# ~~4635-50-5104.415~~ 4626388300.000 DATE 2/24/05

OWNER OR CONTRACTOR THE FARMS LLC / ES Johnson Eldr. PHONE: Business _____ Home _____

ADDRESS 2214 BRAWLEY SCHOOL MOORESVILLE NC 28115

LOCATION BRAWLEY SCHOOL - TR McKENDREE - TL BAYBERRY - ON LT - CORNER OF EWART

SUBDIVISION THE FARMS BLOCK / SECTION 3 LOT 418 LOT AREA .834C SITE CLASS. CS DESIGN FLOW 480GD L.T.A.R. .2566/Res

Septic Tank: ~~1000~~ 1500 Gallons; STB 338 Date 1-15-06

Pump Tank: 1000 Gallons; PT 283 Date 10-11-05

Pump Make: Myers Model ME 3E2T Serial No. _____

Nitrification Field: No. Fields 1 Square Feet 1500 Linear Feet 500

No Lines 5@100' Trench Width 36" Max Trench Bottom Depth 30" Gravel Depth N/A

☑ New System ☐ Repair System Type: I, II, III, IV, V, VI

System Description: PUMP 25% REDUCTION

Repair System Description: _____

Maintenance Agreement Required: ☐ Yes ☑ No

☑ House/Mod. Home No. Bedrooms 4

☐ Mobile Home No. Bathrooms 4

☐ Business No. Employees _____


☐ Other _____

☐ Slab ☑ Crawl Space ☐ Basement w/plumbing ☐ Basement wo/plumbing

Water Supply: ☐ Individual ☐ Public ☐ Community

Comments:/Conditions:

INITIAL SITE SKETCH

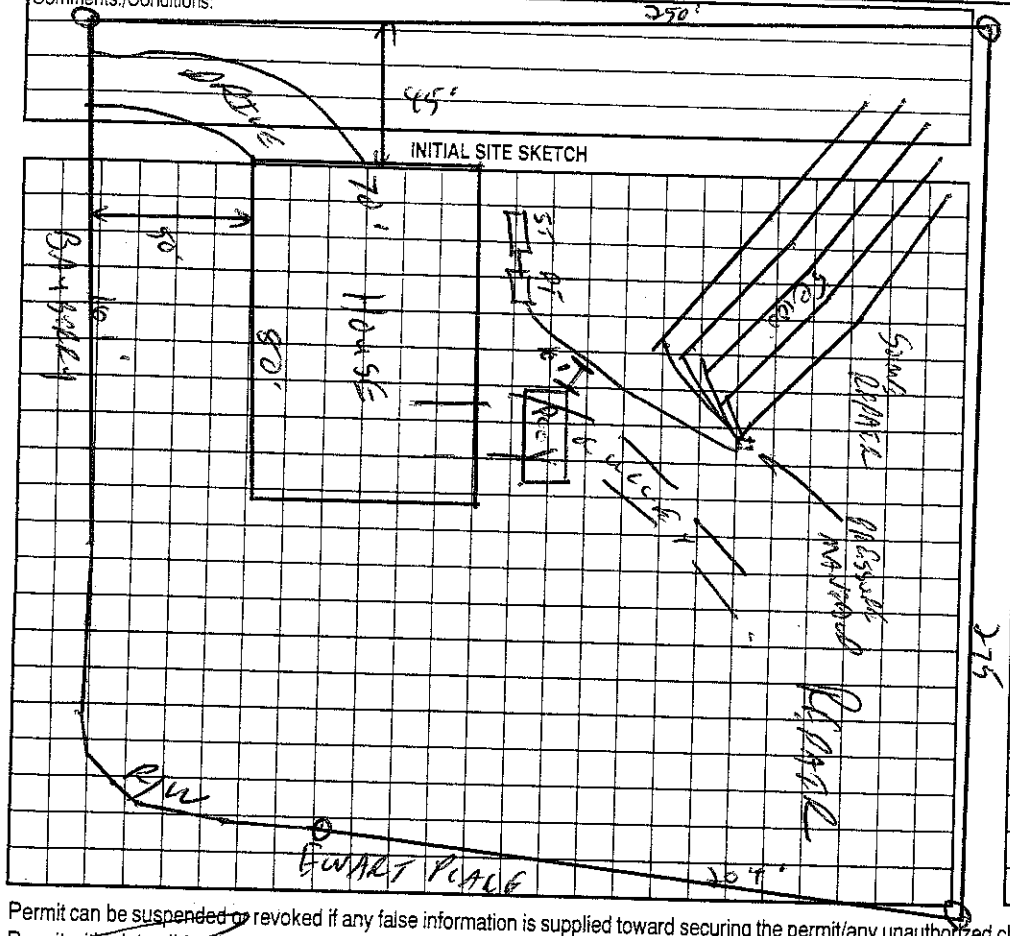

Comments:/Conditions: Tanks & lines Checked 2/28/06

418 & 419 COMBINED

DO NOT CUT HOUSE SITE

EZ Flow

AS BUILT SKETCH

Installed EZ Flow as Drawn Keep Pool 15ft from Septic System (Tanks & lines)

1" = 80'

Permit can be ~~suspended or~~ revoked if any false information is supplied toward securing the permit/any unauthorized changes are made to the site/any unauthorized changes are made in the installation of the system. Improvement Permit with plat ~~valid without expiration.~~ Improvement Permit with site plan valid for sixty months. Authorization to Construct is valid for a period equal to that of Improvement Permit – not to exceed sixty months.

Signed: _____ date 2-24-05 Installed by: Willie Christenbury

Improvement Permit by: C. Gross RS date 2/24/05 Operation Permit by: [illegible] RS date 4/6/06

Authorization to Construct by: [illegible] RS date 4/26/05 Existing System Inspection by: _____ date _____

HEALTH DEPT. COPY: WHITE OWNER COPY (FINAL): YELLOW OWNER COPY (INITIAL): PINK