IREDELL COUNTY HEALTH DEPARTMENT COPY STATESVILLE 704-878-5305 MOORESVILLE 704-664-5281

IMPROVEMENT PERMIT / AUTHORIZATION TO CONSTRUCT / OPERATION PERMIT / EXISTING SYSTEM INSPECTION

3:00

PERMIT# 119623 PIN# 4625505104 4626-38-8713 DATE 7-15-06

OWNER OR CONTRACTOR Warren Smith / Courtland Properties PHONE: Business 363-1622 Home

ADDRESS P.O. Box 3190 Mooresville, NC 28117

LOCATION Brawley School Rd TR McKendree Ct Bayberry Ct Ironwood Ct

SUBDIVISION The Farms BLOCK / SECTION 3 LOT 423 LOT AREA 1 Acre ± SITE CLASS. PS DESIGN FLOW 480gpd L.T.A.R. .3

Septic Tank: 1500+ Gallons: STB 338 Date 7-28-06

Pump Tank: Gallons: PT Date

Pump Make: Model Serial No.

Nitrification Field: No Fields 1 Square Feet 1200' Linear Feet 400'

No Lines 5@80' Trench Width 36" Max Trench Bottom Depth 36" Gravel Depth N/A

[X] New System [ ] Repair System Type: I, II, III, IV, V, VI

System Description: Gravity-25% Reduction

Repair System Description: Pump 25%-50% Reduct

Maintenance Agreement Required: [ ] Yes [X] No

[X] House/Mod. Home No. Bedrooms 4

[ ] Mobile Home No. Bathrooms

[ ] Business No. Employees

[ ] Other

[ ] Slab [X] Crawl Space [ ] Basement w/plumbing [ ] Basement wo/plumbing


Water Supply: [ ] Individual [X] Public [X] Community

Comments:/Conditions: Note: Must keep future pool 15ft from ST & Drainfield


Comments:/Conditions:
- Quick 4's Installed
- Enough Space for pool & setback
- @Tuff-Tite Filter

Scale 1:50'

INITIAL SITE SKETCH

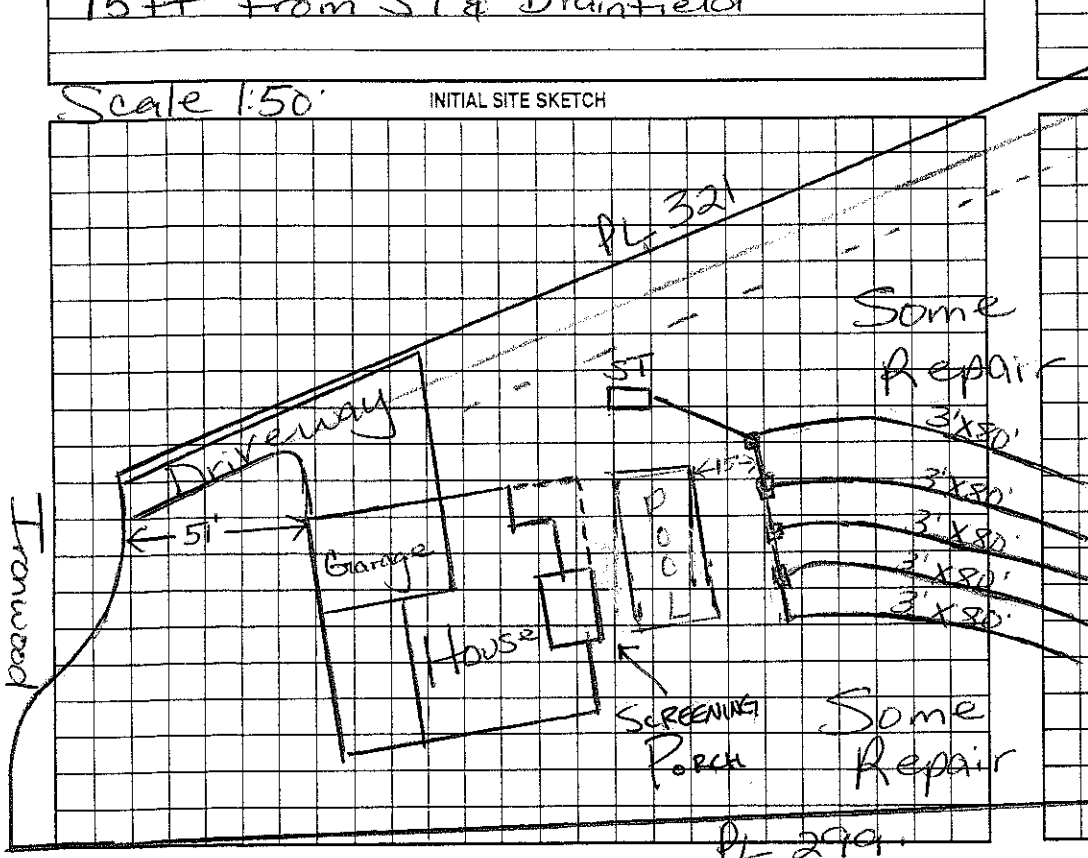

AS BUILT SKETCH

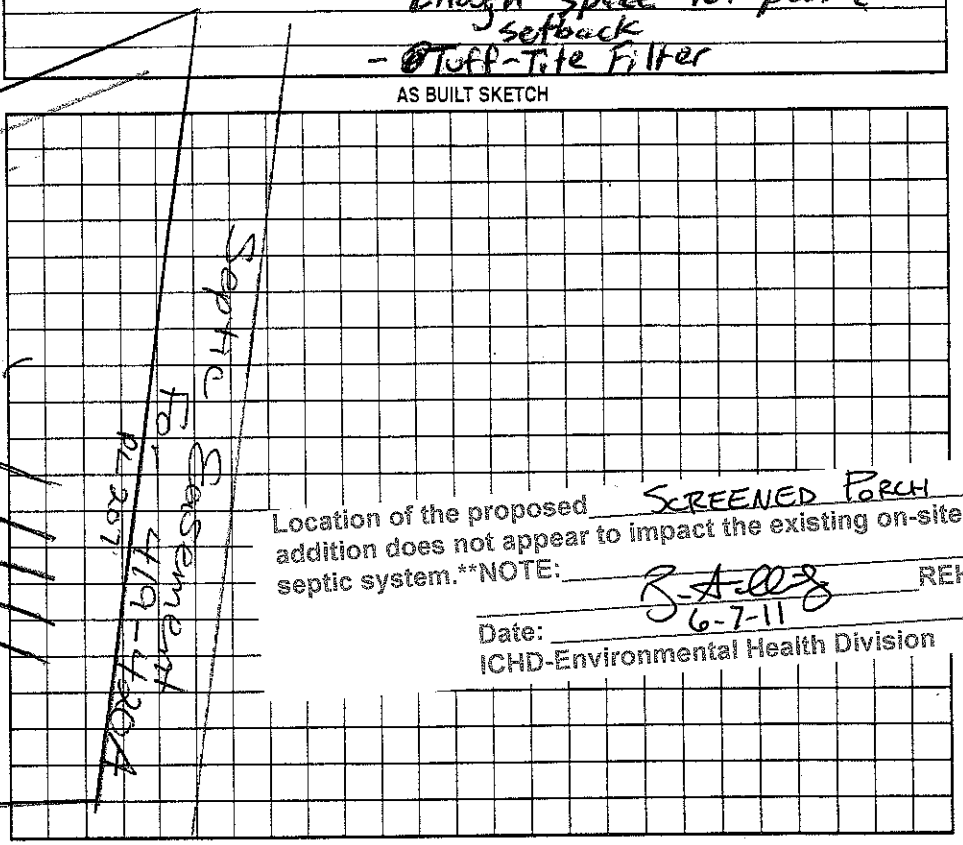

Location of the proposed SCREENED PORCH addition does not appear to impact the existing on-site septic system.**NOTE: REHS

Date: 6-7-11

ICHD-Environmental Health Division

Permit can be suspended or revoked if any false information is supplied toward securing the permit/any unauthorized changes are made to the site/any unauthorized changes are made in the installation of the system. Improvement Permit with plat valid without expiration. Improvement Permit with site plan valid for sixty months. Authorization to Construct is valid for a period equal to that of Improvement Permit – not to exceed sixty months.

Signed: date 9/1/06 Installed by: Stanly Septic

Improvement Permit by: Myria H. Dotson RS date 7/15/06 Operation Permit by: Joseph E. Allen date 9-25-06

Authorization to Construct by: Myria H. Dotson RS date 7/15/06 Existing System Inspection by: date

HEALTH DEPT. COPY: WHITE OWNER COPY (FINAL): YELLOW OWNER COPY (INITIAL): PINK