

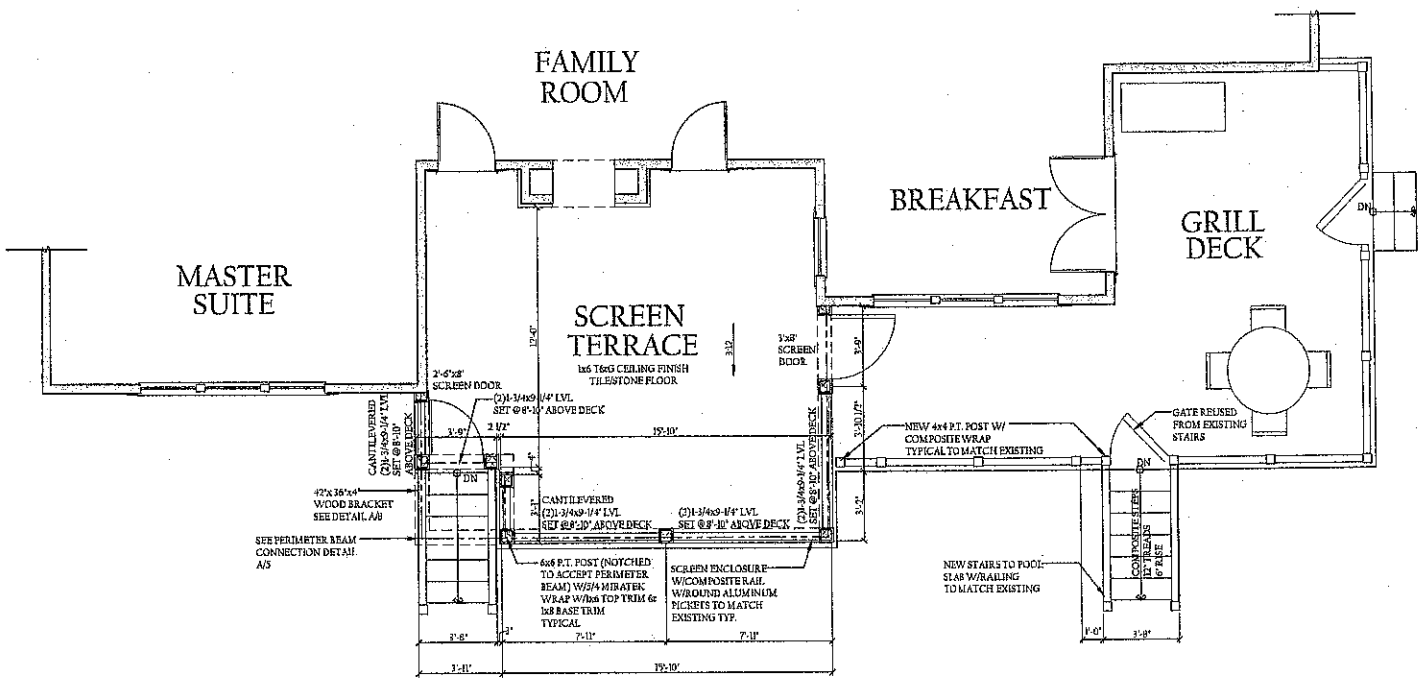


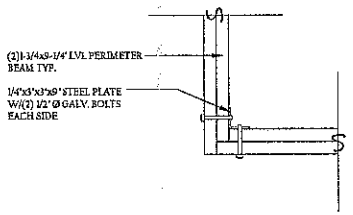

A CANTILEVER BEAM DETAIL
SCALE:1'=1'-0"

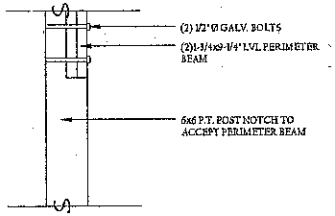

B NOTCHED POST DETAIL
SCALE:1'=1'-0"

ADDITIONAL UNDERROOF SQUARE FOOTAGE	
SCREEN PORCH	326 SQ.FT.

DRAWN BY: ashley j design custom homes and renovations
P.O. BOX 5423 CHARLOTTE, NC 28299
WWW.ASHLEYJDESIGN.COM
704-658-0631
BUILT BY:
704 RENOVATIONS

SEAL:


PROJECT:
GAZAILLE
SCREEN
TERRACE

5/23/11	ENGINEER SET
6/6/11	TO THE FARMS ACC FOR REVIEW

DRAWING:
REVISED
FLOOR
PLAN

SCALE:
1/4"=1'-0"

PAGE:
5
OF 10

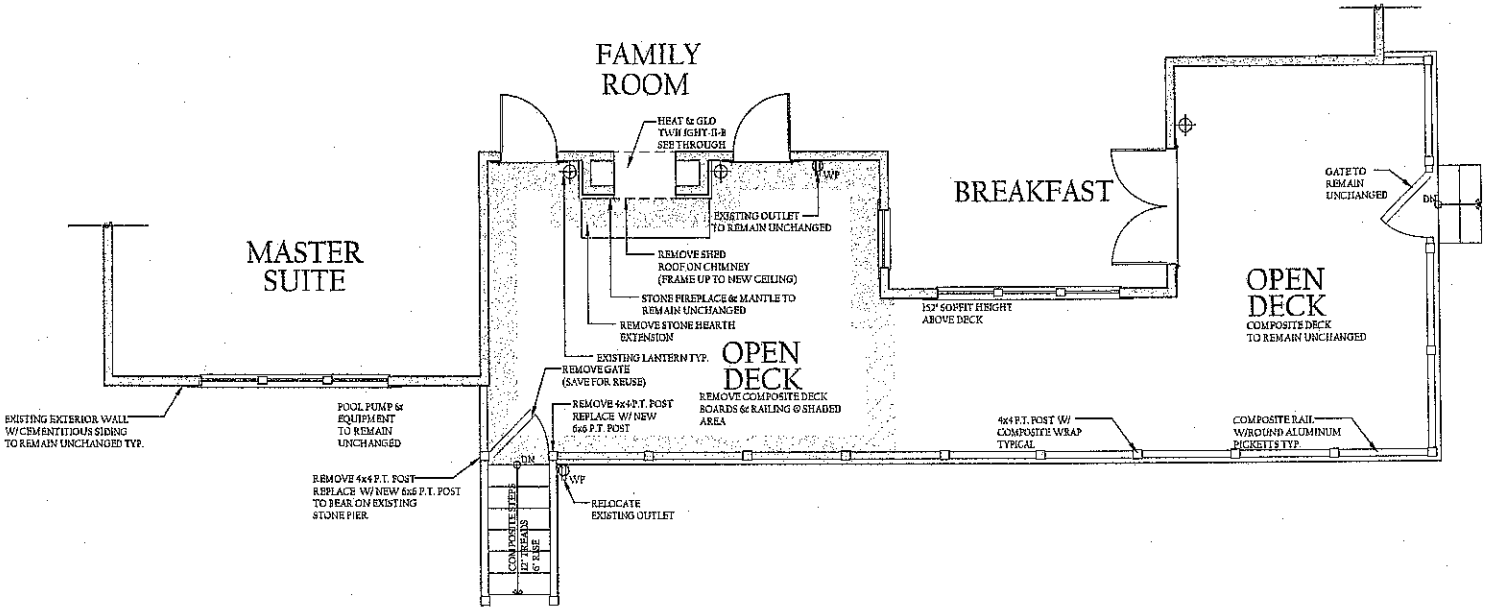

DRAWN BY:

ashley j design
custom homes and renovations
P.O. BOX 5422 CHARLOTTE, NC 28299
WWW.ASHLEYJDESIGN.COM
704-858-0651

BUILT BY:

704 RENOVATIONS

SEAL:

PROJECT:
GAZAILLE SCREEN TERRACE

5/23/11	ENGINEER SET
6/6/11	TO THE FARMS ACC FOR REVIEW

DRAWING:
AS-BUILT PLAN

SCALE:
1/4"=1'-0"

PAGE:
3
OF 10