IREDELL COUNTY HEALTH DEPARTMENT COPY

STATESVILLE 704-878-5305 MOORESVILLE 704-664-5281

IMPROVEMENT PERMIT / AUTHORIZATION TO CONSTRUCT / OPERATION PERMIT / EXISTING SYSTEM INSPECTION

3100

PERMIT# 119623 PIN# 4625505104 4626-38-8713 DATE 7-15-06

OWNER OR CONTRACTOR Warren Smith / Courtland Properties PHONE: Business 363-1622 Home

ADDRESS P.O. Box 3190 Mooresville, NC 28117

LOCATION Brawley School Rd TR McKendree TL Bayberry TL Ironwood Ct

SUBDIVISION The Farms BLOCK / SECTION 3 LOT 423 LOT AREA 1 Acre SITE CLASS. PS DESIGN FLOW 450gpd L.T.A.R. .3

Septic Tank: 1500+ Gallons; STB 338 Date 7-28-06
Pump Tank: Gallons; PT Date
Pump Make: Model Serial No.
Nitrification Field: No. Fields 1 Square Feet 1200' Linear Feet 400'
No. Lines 5@80' Trench Width 36" Max Trench Bottom Depth 36"

[X] New System [ ] Repair System Type: I, II, III, IV, V, VI
System Description: Gravity-25% Reduction
Repair System Description: Pump 25%-50% Reduct
Maintenance Agreement Required: [ ] Yes [X] No
Gravel Depth N/A

[X] House/Mod. Home No. Bedrooms 4
[ ] Mobile Home No. Bathrooms
[ ] Business No. Employees
[ ] Other
[ ] Slab [X] Crawl Space [ ] Basement w/plumbing [ ] Basement wo/plumbing


Water Supply: [ ] Individual [X] Public [X] Community

Comments:/Conditions: Note: Must keep future pool 15Ft from ST & Drainfield


Comments:/Conditions:
- Quick 4's Installed
- Enough Space for pool & setback
- @Toff-Tite Filter

Scale 1:50'

INITIAL SITE SKETCH

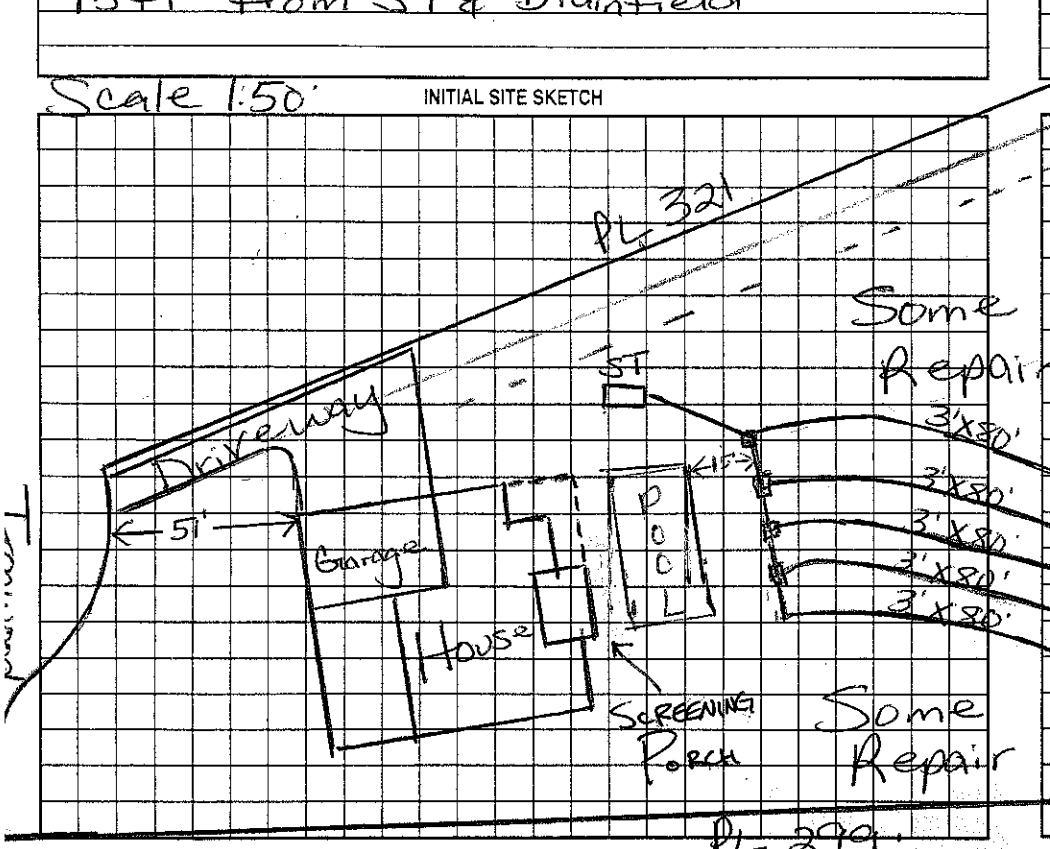

AS BUILT SKETCH

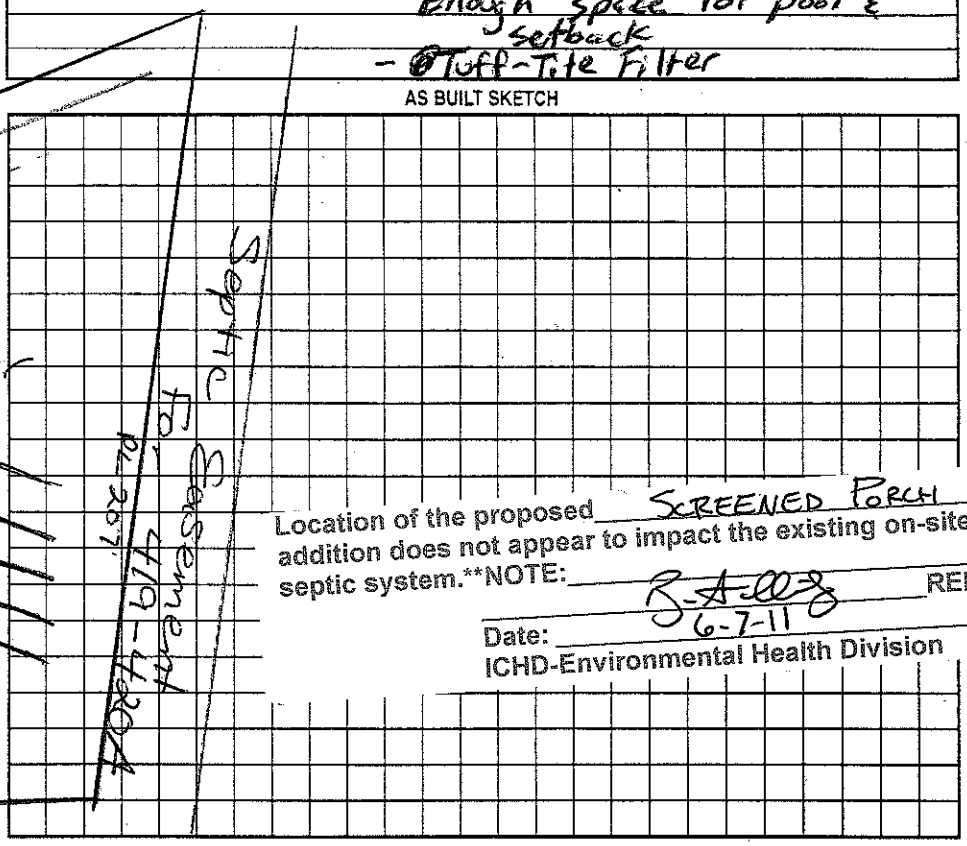

Permit can be suspended or revoked if any false information is supplied toward securing the permit/any unauthorized changes are made to the site/any unauthorized changes are made in the installation of the system. Improvement Permit with plat valid without expiration. Improvement Permit with site plan valid for sixty months. Authorization to Construct is valid for a period equal to that of Improvement Permit – not to exceed sixty months.

Signed: Joshua Turk date 9/1/06 Installed by: Stanly Septic

Improvement Permit by: Maria H. Dobson RS date 7/15/06 Operation Permit by: Joseph E. Allen date 9-25-06

Authorization to Construct by: Maria H. Dobson RS date 7/15/06 Existing System Inspection by: date

HEALTH DEPT. COPY: WHITE OWNER COPY (FINAL): YELLOW OWNER COPY (INITIAL): PINK