IREDELL COUNTY HEALTH DEPARTMENT

STATESVILLE 704-878-5305 MOORESVILLE 704-664-5281

IMPROVEMENT PERMIT / AUTHORIZATION TO CONSTRUCT / OPERATION PERMIT / EXISTING SYSTEM INSPECTION

4:00

PERMIT# 119617 PIN# 4626389452 DATE 12-21-06

OWNER OR APPLICANT Darryl Hoke PHONE: Business 799-7495 Home

ADDRESS P.O. Box 4448 Mooresville, NC 28117

LOCATION Brawley School TR McKendree TR Bayberry TR Ewart on left

SUBDIVISION The Farms BLOCK / SECTION 3 LOT 417 LOT AREA .81 Acre SITE CLASS PS DESIGN FLOW 600 L.T.A.R. .25

Septic Tank: 1500 Gallons; STB 449 Date 2/16/07
Pump Tank: 1500 Gallons; PT 477 Date 2/15/07
Pump Make: Myers Model ME50 Serial No.
Nitrification Field(s) No. Fields 1 Square Feet 1800 Linear Feet 600'
No. Lines 7 Trench Width 36" Max Trench Bottom Depth 24"

☒ New System ☐ Repair ☐ Expansion System Type: I II III IV V VI
System Description: LP-25% Reduction
Repair System Description: Same
Maintenance Agreement Required: ☒ Yes ☐ No
Gravel Depth N/A ☐ Gravity ☒ Pressure

☒ House/Mod. Home No. Bedrooms 5
☐ Mobile Home No. Persons
☐ Business No. Employees
☐ Other


Water Supply: ☐ Individual ☒ Public ☒ Community

☐ Slab ☒ Crawl Space ☐ Basement w/plumbing ☐ Basement wo/plumbing

Comments:/Conditions: Note: Shallow Soils stay to 24" trench bottom. Low Pressure distribution

Comments:/Conditions: ☒ Must keep "Future pool" 15ft from tanks & drainlines & 10ft to supply line.
☒ Divert all stormwater away from Septic System.

Scale 1:50 INITIAL SITE SKETCH

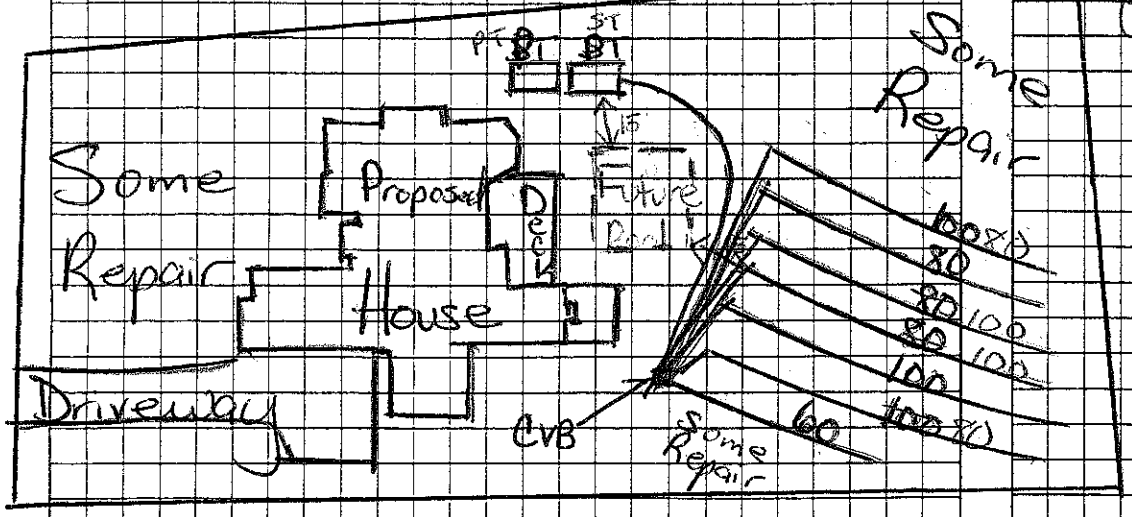

CVB = Central Gate Valve Box

AS BUILT SKETCH

Drilled 3/16" hole
Checked 5 of 7 lines
Checked other 2 lines at Tanks 3/20/07

Permit can be suspended or revoked if any false information is supplied toward securing the permit/any unauthorized changes are made to the site/any unauthorized changes are made in the installation of the system. Improvement Permit with plat valid without expiration ☐ Improvement Permit with site plan valid for sixty months ☐ Authorization to Construct is valid for a period equal to that of Improvement Permit – not to exceed sixty months.

Signed: Doug Wolf date 12/18/06 Installed by: R & H

Improvement Permit by: Myra H. Dobson RS date 12/21/06 Operation Permit by: Jeff E Alp date 7-10-07

Authorization to Construct by: Myra H. Dobson RS date 12/21/06 Existing System Inspection by: date

HEALTH DEPT. COPY: WHITE OWNER COPY (FINAL): YELLOW OWNER COPY (INITIAL): PINK