IREDELL COUNTY HEALTH DEPARTMENT

STATESVILLE 704-878-5305 MOORESVILLE 704-664-5281

IMPROVEMENT PERMIT / AUTHORIZATION TO CONSTRUCT / OPERATION PERMIT / EXISTING SYSTEM INSPECTION

PERMIT# 092452 PIN# 4626 38 7480 PT DATE 9-25-00

OWNER OR CONTRACTOR EASTER DEVELOP. CORP PHONE: Business 664-2906 Home

ADDRESS 227 Hideaway Ln Mooresville NC 28117

LOCATION Brawley School, R. McKendree, R. Ardmore Place ONLT

SUBDIVISION Blackberry Creek BLOCK / SECTION II LOT 11 LOT AREA .81 acre SITE CLASS. PS DESIGN FLOW ~~300~~ 360 L.T.A.R. .360/KT-2

Septic Tank: 1000 Gallons; STB Date

Pump Tank: Gallons; PT Date

Pump Make: Model Serial No.

Nitrification Field: No Fields 1 Square Feet 1000 Linear Feet 400

No Lines 4@100 Trench Width 36" Max Trench Bottom Depth 36" Gravel Depth 12"

☒ New System ☐ Repair System Type: I, (II), III, IV, V, VI

System Description: GRAVITY CONVENTIONAL

Repair System Description: SAME

Maintenance Agreement Required: ☐ Yes ☒ ~~No~~

☒ House/Mod. Home No. Bedrooms 3

☐ Mobile Home No. Bathrooms 2½

☐ Business No. Employees

☐ Other

☐ Slab ☑ Crawl Space ☐ Basement w/plumbing ☐ Basement wo/plumbing


Water Supply: ☒ Individual ☐ Public ☐ Community

Comments:/Conditions: 1) REMOVE TERRACES AND BERMS


2) CONTOURS MAY CHANGE SLIGHTLY AFTER TERRACES ARE REMOVED

Comments:/Conditions:

INITIAL SITE SKETCH 1"=50'

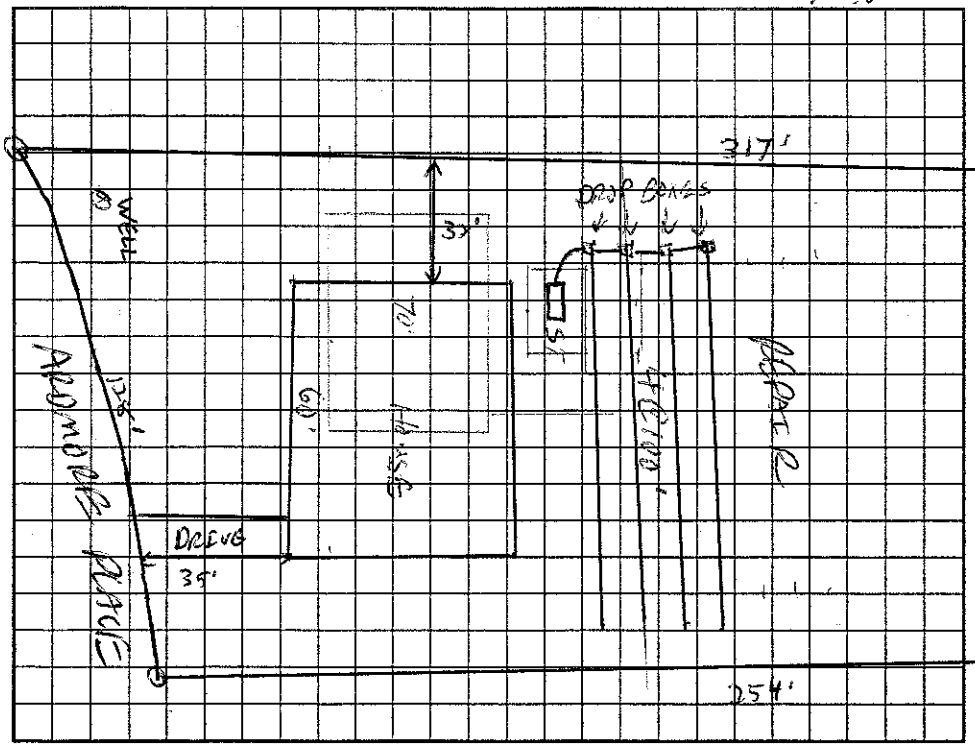

AS BUILT SKETCH

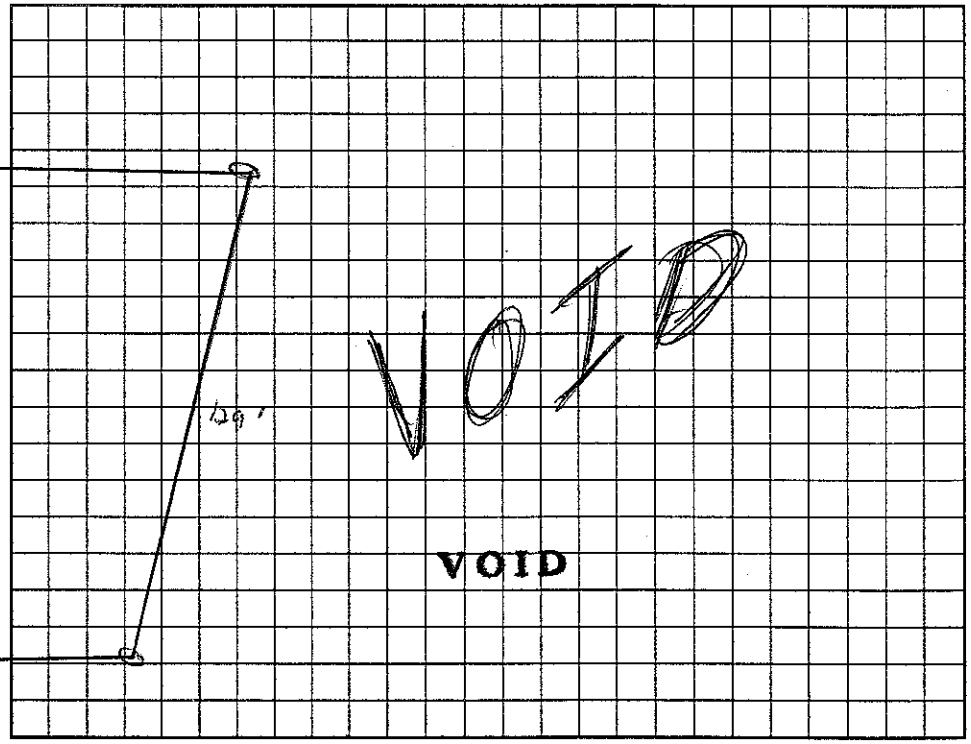

Permit can be suspended or revoked if any false information is supplied toward securing the permit/any unauthorized changes are made to the site/any unauthorized changes are made in the installation of the system. Improvement Permit with plat valid without expiration. Improvement Permit with site plan valid for sixty months. Authorization to Construct is valid for a period equal to that of Improvement Permit – not to exceed sixty months.

Signed: [signature] date 9-25-00 Installed by:

Improvement Permit by: [signature] date 11/3/00 Operation Permit by: date

Authorization to Construct by: date Existing System Inspection by: date

HEALTH DEPT. COPY: WHITE OWNER COPY (FINAL): YELLOW OWNER COPY (INITIAL): PINK