IREDELL COUNTY HEALTH DEPARTMENT

STATESVILLE 704-878-5305 MOORESVILLE 704-664-5281

IMPROVEMENT PERMIT / AUTHORIZATION TO CONSTRUCT / OPERATION PERMIT / EXISTING SYSTEM INSPECTION

PERMIT# 092454 PIN# ~~4626-38-7480-PT~~ 4626-39-2632 DATE 9-25-00

OWNER OR CONTRACTOR EASTER DEVELOP. CORP. PHONE: Business 664-2906 Home

ADDRESS 227 Hideaway Ln Mooresville NC 28117

LOCATION Brawley School, R. McKendree, R Ardmore Place ON LT

SUBDIVISION Blackberry Creek BLOCK / SECTION II LOT 12 LOT AREA .71 acre SITE CLASS. PS DESIGN FLOW 360GPD L.T.A.R. .36GPD/FT2

Septic Tank: 1000 Gallons: STB 1007 Date 4-3-01
Pump Tank: Gallons; PT Date
Pump Make: Model Serial No.
Nitrification Field: No Fields 1 Square Feet 1200 Linear Feet 400
No Lines 4@10' Trench Width 36" Max Trench Bottom Depth 36" Gravel Depth 12"

☒ New System ☐ Repair System Type: I (II) III, IV, V, VI
System Description: GRAVITY CONVENTIONAL
Repair System Description: SAME
Maintenance Agreement Required: ☐ Yes ☒ No

☒ House/Mod. Home No. Bedrooms 3
☐ Mobile Home No. Bathrooms 2½
☐ Business No. Employees
☐ Other
☐ Slab ☒ Crawl Space ☐ Basement w/plumbing ☐ Basement wo/plumbing


Water Supply: ☒ Individual ☐ Public ☐ Community

Comments:/Conditions: CONTOURS MAY CHANGE SLIGHTLY WHEN TERRACES AND BERMS ARE REMOVED.


Comments:/Conditions:

ENTERED

INITIAL SITE SKETCH 1"=50'

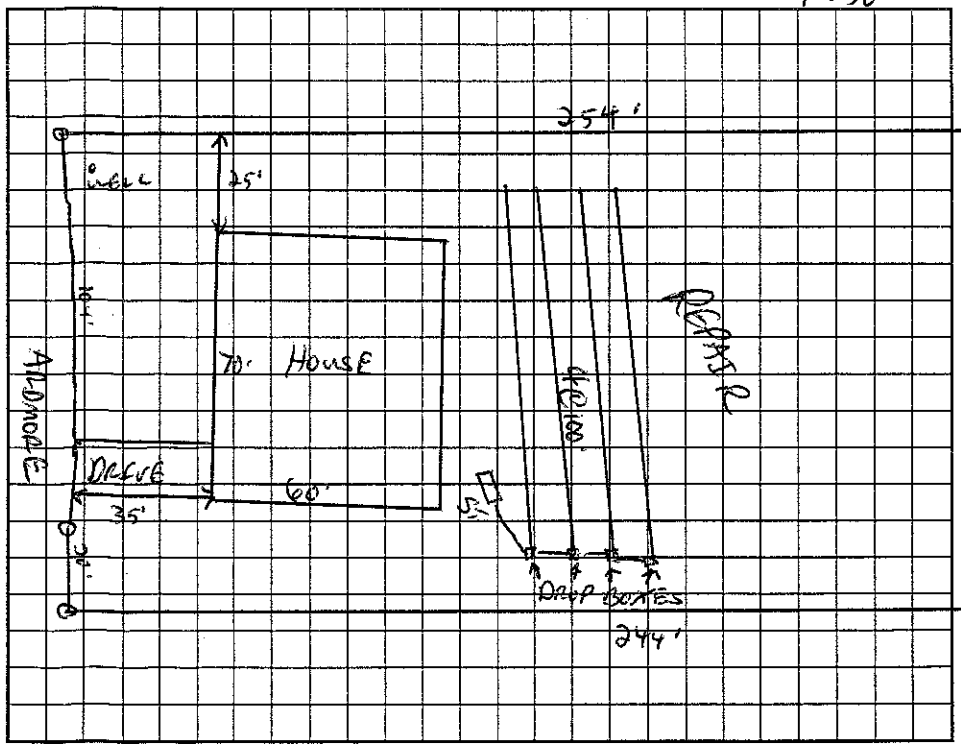

AS BUILT SKETCH

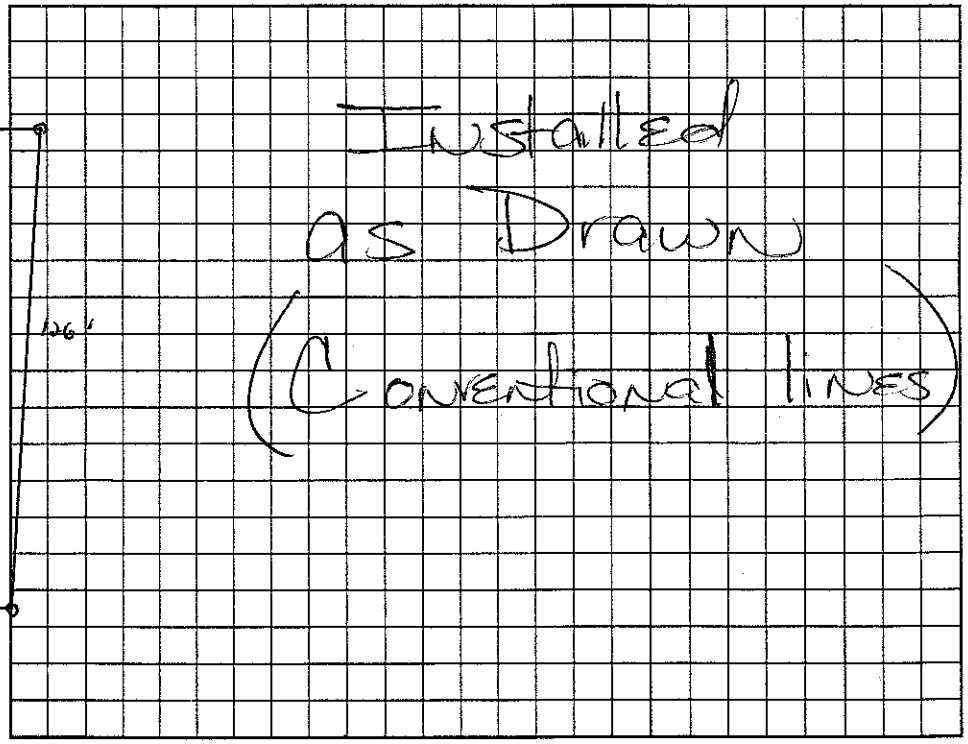

Permit can be suspended or revoked if any false information is supplied toward securing the permit/any unauthorized changes are made to the site/any unauthorized changes are made in the installation of the system. Improvement Permit with plat valid without expiration. Improvement Permit with site plan valid for sixty months. Authorization to Construct is valid for a period equal to that of Improvement Permit – not to exceed sixty months.

Signed: date 9-25-00 Installed by: Wayne

Improvement Permit by: C. B. Team RS date 11/7/00 Operation Permit by: Melissa A. Hall date 6/27/2001

Authorization to Construct by: C. B. RS date 3/6/01 Existing System Inspection by: date

HEALTH DEPT. COPY: WHITE OWNER COPY (FINAL): YELLOW OWNER COPY (INITIAL): PINK