# IREDELL COUNTY HEALTH DEPARTMENT

STATESVILLE 704-878-5305 MOORESVILLE 704-664-5281

## IMPROVEMENT PERMIT / AUTHORIZATION TO CONSTRUCT / OPERATION PERMIT / EXISTING SYSTEM INSPECTION

~~400~~ ~~200~~ 1130

PERMIT# 092456 PIN# ~~4626 38 7480 PT~~ 4626 39 2724 DATE 9-25-00

OWNER OR CONTRACTOR EASTER DEVELOP. CORP PHONE: Business 664-2906 Home

ADDRESS 227 Hideaway Ln Mooresville NC 28117

LOCATION Brawley School, R. McKendree, R. Ardmore Place ON LT

SUBDIVISION Blackberry Creek BLOCK / SECTION II LOT 13 LOT AREA .70 acre SITE CLASS. PS DESIGN FLOW 360 GPD L.T.A.R. .30 PD/FT

Septic Tank: 1000 Gallons; STB 825 Date 3-2-01
Pump Tank: Gallons; PT Date
Pump Make: Model Serial No.
Nitrification Field: No Fields 1 Square Feet 900 Linear Feet 300
No Lines 6 @ 60' Trench Width 36" Max Trench Bottom Depth 36" Gravel Depth N/A


☒ New System ☐ Repair System Type: I, II, ☒ III, IV, V, VI
System Description: GRAVITY 25% REDUCTION
Repair System Description: GRAVITY PANEL
Maintenance Agreement Required: ☐ Yes ☒ No

☒ House/Mod. Home No. Bedrooms 3
☐ Mobile Home No. Bathrooms 2½
☐ Business No. Employees
☐ Other
☐ Slab ☒ Crawl Space ☐ Basement w/plumbing ☐ Basement wo/plumbing

Water Supply: ☒ Individual ☐ Public ☐ Community


Comments:/Conditions: 1) REMOVE TERRACES AND BERMS
2) FILL GULLEY PROPERLY TO BRING LINES 5' FROM GULLEY.
Some huge Boulders found in Drain Field

INITIAL SITE SKETCH 1" = 50'

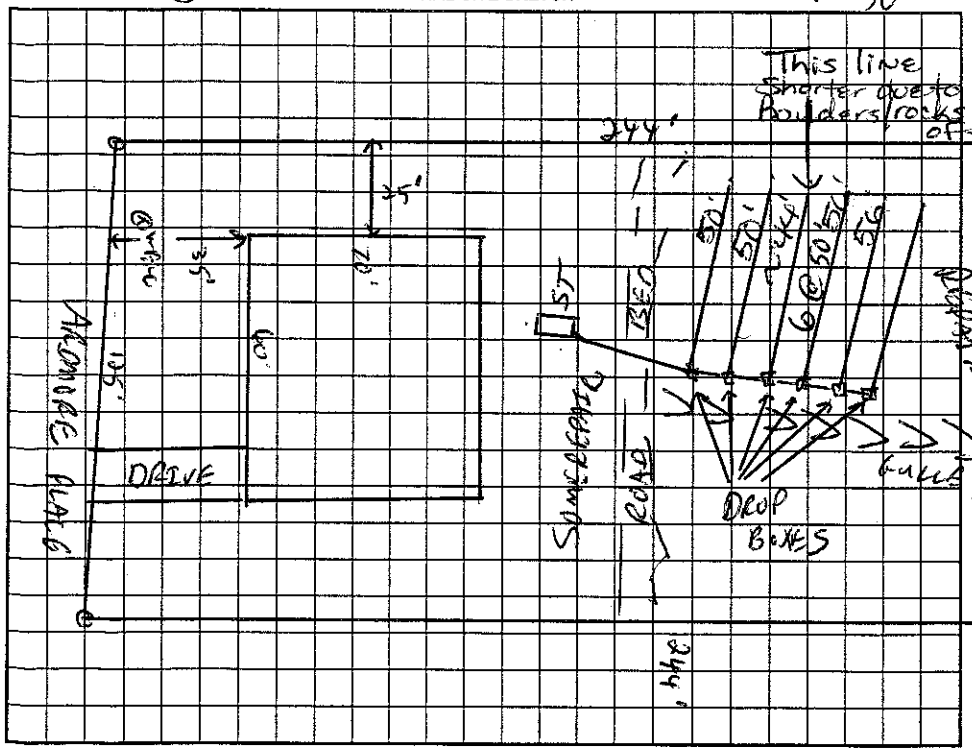


Comments:/Conditions: Filter not installed yet: Checked 4/9/01
Checked upper 2 lines & tank, 4/5/2001 mke
Checked lines 3, 4, 5 4/6/2001 mke
Checked 6th line 4/9/2001 mke

AS BUILT SKETCH

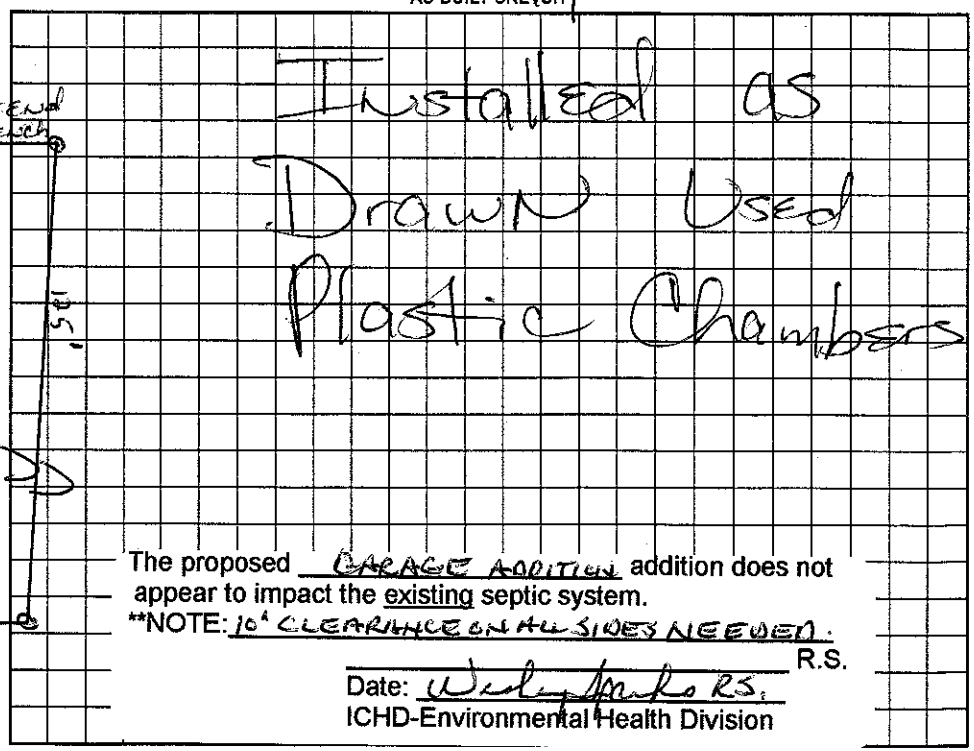


The proposed GARAGE ADDITION addition does not appear to impact the existing septic system.
**NOTE: 10' CLEARANCE ON ALL SIDES NEEDED.

R.S.
ICHD-Environmental Health Division

Permit can be suspended or revoked if any false information is supplied toward securing the permit/any unauthorized changes are made to the site/any unauthorized changes are made in the installation of the system. Improvement Permit with plat valid without expiration. Improvement Permit with site plan valid for sixty months. Authorization to Construct is valid for a period equal to that of Improvement Permit – not to exceed sixty months.

Signed: date 9-25-00 Installed by: Wayne Gantz

Improvement Permit by: date 11/7/00 Operation Permit by: RS. date 4/9/2001

Authorization to Construct by: date 1/23/00 Existing System Inspection by: date

HEALTH DEPT. COPY: WHITE OWNER COPY (FINAL): YELLOW OWNER COPY (INITIAL): PINK