IREDELL COUNTY HEALTH DEPARTMENT

PIN# 4626-39-5715

STATESVILLE 704-878-5305 MOORESVILLE 704-664-5281

IMPROVEMENT PERMIT / AUTHORIZATION TO CONSTRUCT / OPERATION PERMIT / EXISTING SYSTEM INSPECTION

PERMIT# 092475 PIN# ~~4626 38 7480 PT~~ Lewis Carpentar DATE 9-25-00

OWNER OR CONTRACTOR EASTER DEVELOP CORP PHONE: Business 664-2906 Home

ADDRESS 227 Hideaway Ln Mooresville NC 28117

LOCATION Brawley School R McKendree R. Ambrose Place ON LT

SUBDIVISION Blackberry Creek BLOCK / SECTION II LOT 14 LOT AREA .80 acre SITE CLASS. PS DESIGN FLOW 360 GPD L.T.A.R. .30 GPD/FT²

Septic Tank: 1000 Gallons; STB 794 Date 11-17-01

Pump Tank: Gallons; PT Date

Pump Make: Model Serial No.

Nitrification Field: No Fields 1 Square Feet 900 Linear Feet 300

No Lines 3 @ 100' Trench Width 36" Max Trench Bottom Depth 36" Gravel Depth MA

☒ New System ☐ Repair System Type: I, II, III, IV, V, VI

System Description: GRAVITY 25% REDUCTION

Repair System Description: GRAVITY EXPEC

Maintenance Agreement Required: ☐ Yes ☒ No

☒ House/Mod. Home ☐ Mobile Home ☐ Business ☐ Other

No. Bedrooms 3 No. Bathrooms 2½ No. Employees


☐ Slab ☒ Crawl Space ☐ Basement w/plumbing ☐ Basement wo/plumbing

Water Supply: ☒ Individual ☐ Public ☐ Community


Comments:/Conditions: REMOVE TERRACE AND BERMS

Comments:/Conditions: Filter installed

INITIAL SITE SKETCH 1"=50'

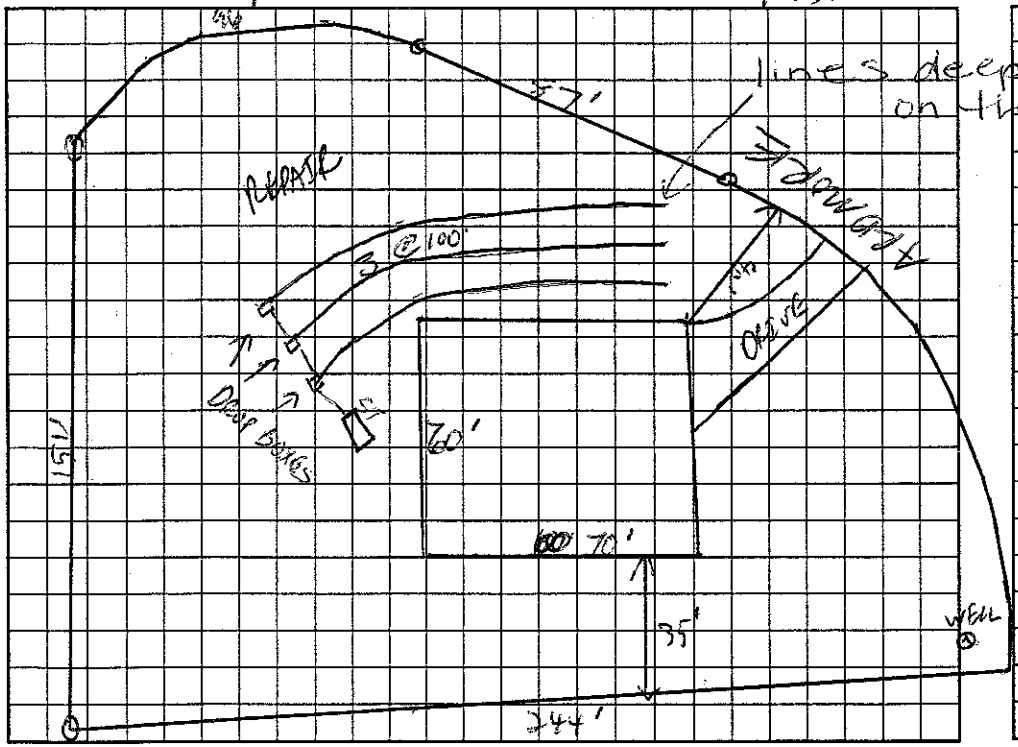

AS BUILT SKETCH

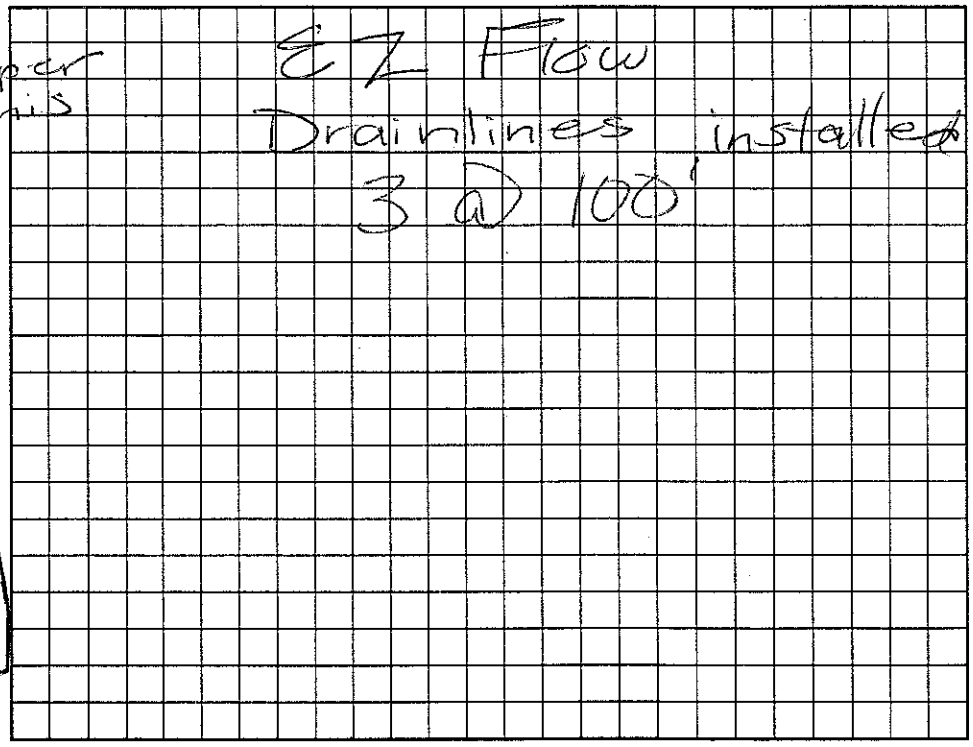

Permit can be suspended or revoked if any false information is supplied toward securing the permit/any unauthorized changes are made to the site/any unauthorized changes are made in the installation of the system. Improvement Permit with plat valid without expiration. Improvement Permit with site plan valid for sixty months. Authorization to Construct is valid for a period equal to that of Improvement Permit – not to exceed sixty months.

Signed: [signature] date 9-25-00 Installed by: Larry Beam

Improvement Permit by: [signature] RS date 11/9/00 Operation Permit by: [signature] RS date 1/8/2002

Authorization to Construct by: [signature] RS date 11/28/01 Existing System Inspection by: date

HEALTH DEPT. COPY: WHITE OWNER COPY (FINAL): YELLOW OWNER COPY (INITIAL): PINK