IREDELL COUNTY HEALTH DEPARTMENT

Statesville Office (704) 878-5305 Mooresville Office (704) 660-3625 PERMIT # 213907

IMPROVEMENT PERMIT / AUTHORIZATION TO CONSTRUCT / OPERATION PERMIT / EXISTING SYSTEM

PIN # 4626392818

APPLICANT: Trevor Ashline APPLICANT ADDRESS: 115 Cloverhill Rd. Mooresville, NC

SITE ADDRESS: 143 Ardmore Place Mooresville, NC PHONE: ALT. PHONE: 803 230-1300

SITE DIRECTIONS: Brawley School Rd TR McKendree TR Ardmore Place on left

SUBDIVISION: Blackberry Creek SECTION: II LOT # 14 LOT AREA: .80 Acre DESIGN FLOW: 360gpd L.T.A.R.: +3

Existing

Septic Tank 1000 (gal) STB ( ) Date
Pump Tank (gal) PT Date
Pump Make Model Serial #
Nitrification Fields 1 # Lines 3 Linear Ft: 300'
Trench Width 36" Max. Trench Bottom Depth 36" Gravel Depth N/A

☐ New System ☐ Repair ☐ Expansion System Type: I II (III) IV V VI
System Description: Exist. Gravity - 25% Reduct.
Repair System Description: Gravity PPBPS
Maintenance Agreement Required: ☐ YES ☒ NO
☒ GRAVITY ☐ PRESSURE


☒ Residence No. Bedrooms 3
☐ Business No. Persons To
☐ Other No. Employees
☐ Slab ☒ Crawl Space
☐ Basement w/plumbing ☐ Basement w/o plumbing

Water Supply: ☒ Private ☐ Public ☐ Community

Comments / Conditions: Must keep Garage at least 25' ft from well & at least 5ft from Septic.

The proposed detached garage does not appear to impact the existing Septic System or well

INITIAL SITE SKETCH

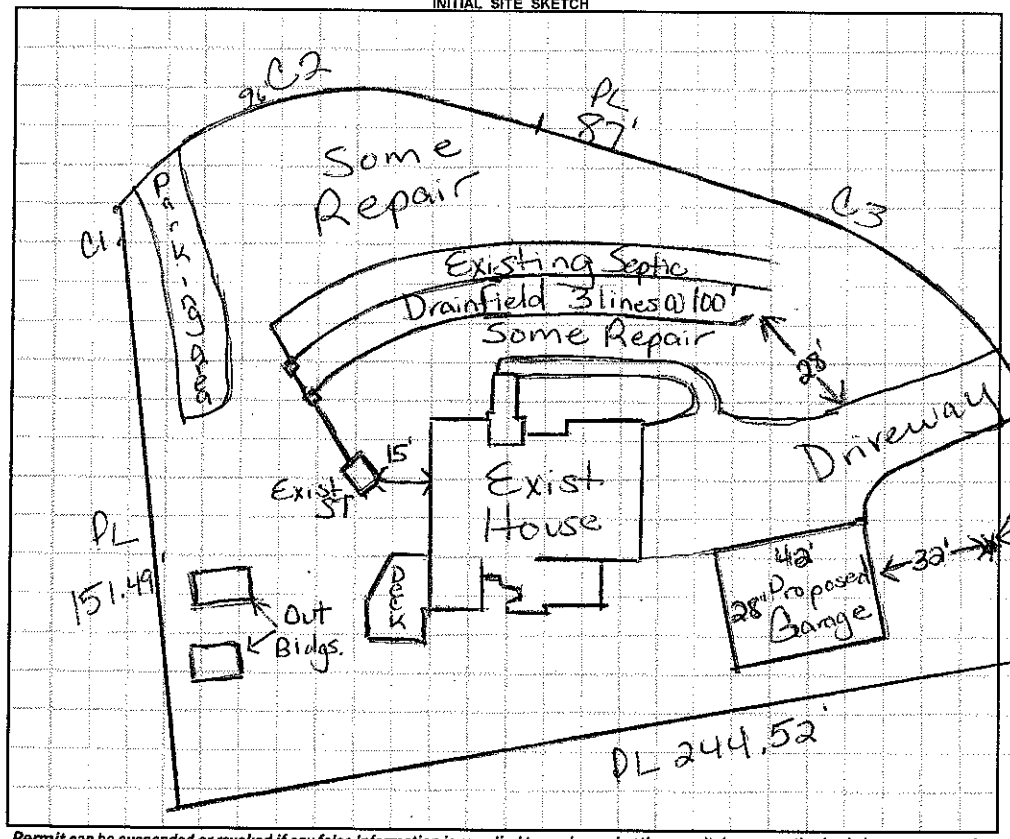

AS BUILT SKETCH

Permit can be suspended or revoked if any false information is supplied toward securing the permit / any unauthorized changes are made to the site / any unauthorized changes are made in the installation of the system. **CONTACT A LOCATOR SERVICE PRIOR TO ANY EXCAVATION**

☐ **IMPROVEMENT PERMIT** ***with plat*** *valid without expiration.* ☐ **IMPROVEMENT PERMIT** ***with site plan*** *valid for 60 mos.* ☐ **AUTHORIZATION TO CONSTRUCT** *valid for period equal to IMPROVEMENT PERMIT--not to exceed 60 mo.*

Owner / Applicant Signature: Trevor P. Ashline Date: 11-5-15 Installed by:

IMPROVEMENT PERMIT by: Date: OPERATION PERMIT by: Date:

AUTHORIZATION TO CONSTRUCT by: Date: Existing System Inspected by: Maria H Dotson RS Date: 11/2/15

Health Dept. Copy - WHITE Applicant (Final Approval) - YELLOW Applicant (Conditional Approval) - PINK