IREDELL COUNTY HEALTH DEPARTMENT

STATESVILLE 704-878-5305 125.00 Paid MOORESVILLE 704-664-5281 11:00

IMPROVEMENT PERMIT / AUTHORIZATION TO CONSTRUCT / OPERATION PERMIT / EXISTING SYSTEM INSPECTION

PERMIT# 092450 PIN# ~~4626 38 7480 PT~~ 4626-39-3328 DATE 9-25-00

OWNER OR CONTRACTOR EASTER DEVELOP. CORP. (KLENOTIZ) PHONE: Business 664-2906 Home

ADDRESS 227 Hideaway Ln Mooresville NC 28117

LOCATION Brawley School, R. McKendree TRAILMORE - ON LT

SUBDIVISION Blackberry Creek II BLOCK / SECTION II LOT 10 LOT AREA .80 Acre SITE CLASS PS DESIGN FLOW 360 GPD L.T.A.R. .30 PD/FT²

Septic Tank: 1000 Gallons; STB 794 Date 3-14-01

Pump Tank: Gallons; PT Date

Pump Make: Model Serial No.

Nitrification Field: No Fields 1 Square Feet ~~1000~~ 900 Linear Feet ~~400~~ 300

No Lines 3 X @ 100' Trench Width 36" Max Trench Bottom Depth 36" Gravel Depth 12"

☒ New System ☐ Repair System Type: I II III IV V VI

System Description: GRAVITY CONVENTIONAL 25% REDUCTION

Repair System Description: GRAVITY 25% REDUCTION

Maintenance Agreement Required: ☐ Yes ☐ No

☒ House/Mod. Home No. Bedrooms 3

☐ Mobile Home No. Bathrooms 2½

☐ Business No. Employees

☐ Other

☐ Slab ☒ Crawl Space ☐ Basement w/plumbing ☐ Basement wo/plumbing

Water Supply: ☒ Individual ☐ Public ☐ Community


Comments:/Conditions: REMOVE ~~2~~ TERRACES AND BERMS

4/5/01 - Spoke w/Brad Russell OK'd change to EZ Flow drainlines - AWS


Comments:/Conditions: Filter & riser installed.

Distribution box used.

INITIAL SITE SKETCH (1"=50')

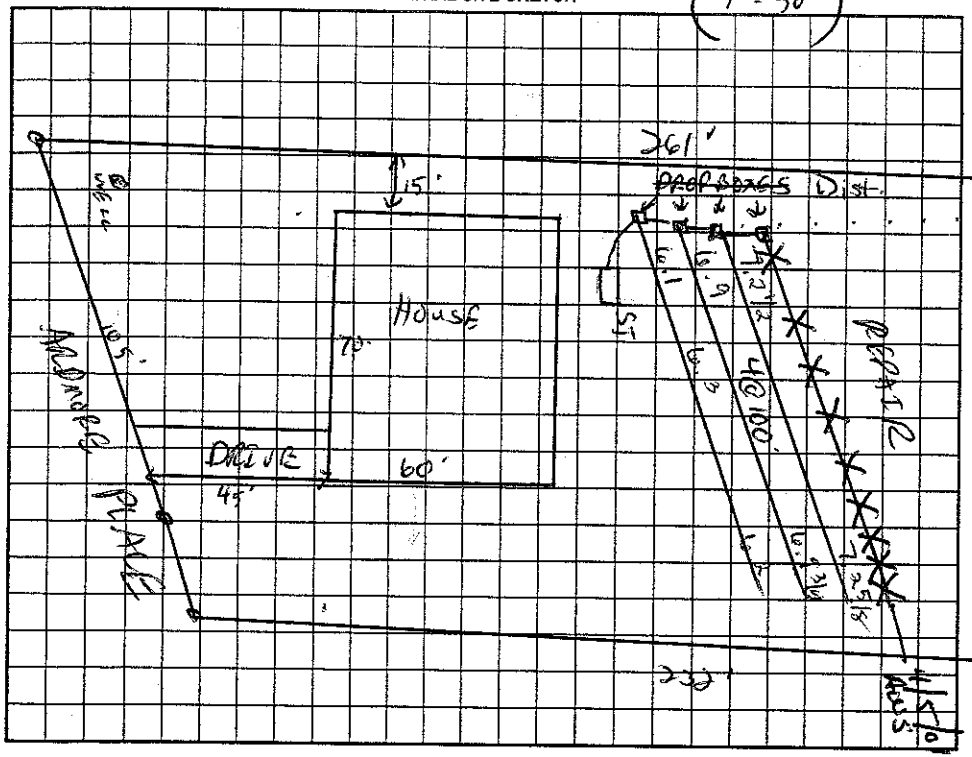

AS BUILT SKETCH

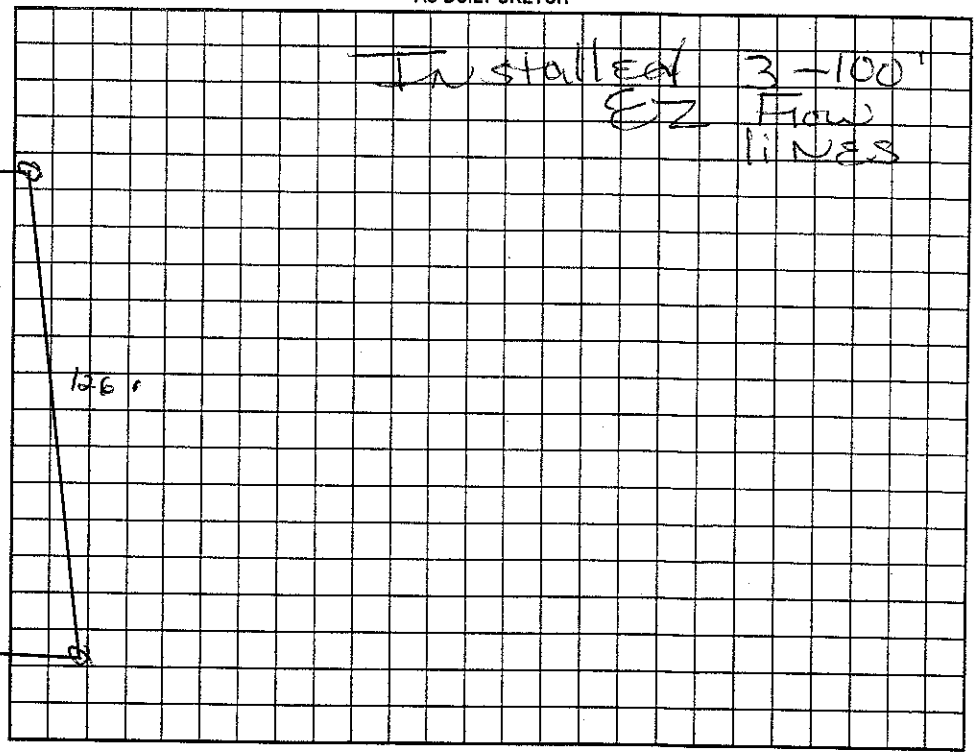

Permit can be suspended or revoked if any false information is supplied toward securing the permit/any unauthorized changes are made to the site/any unauthorized changes are made in the installation of the system. Improvement Permit with plat valid without expiration. Improvement Permit with site plan valid for sixty months. Authorization to Construct is valid for a period equal to that of Improvement Permit – not to exceed sixty months.

Signed: date 9-25-00 Installed by: R & H

Improvement Permit by: ES date 11/8/00 Operation Permit by: RS date 4/17/2001

Authorization to Construct by: Wesley Sparks RS. date 11/14/00 Existing System Inspection by: date

HEALTH DEPT. COPY: WHITE OWNER COPY (FINAL): YELLOW OWNER COPY (INITIAL): PINK