IREDELL COUNTY HEALTH DEPARTMENT

STATESVILLE 704-878-5305 4626394888 MOORESVILLE 704-664-5281

IMPROVEMENT PERMIT / CERTIFICATE OF COMPLETION / OPERATION PERMIT / EXISTING SYSTEM INSPECTION

PROPERTY DESCRIPTION NO. 21646 DATE Aug 11, '95 TAX MAP NO. 2L2A-355 Watershed: ☑ Yes ☐ No

OWNER OR CONTRACTOR Craig Pelchat PHONE: Business Home 664-6981 WS4

ADDRESS 151 Broadleaf Dr. Mooresville

LOCATION Brawley Sch Rd TR McKendree TR Ardmore Pl ≈ 500' on Right

SUBDIVISION Crescent BLOCK / SECTION 8 LOT 605 LOT AREA 1.06Ac SITE CLASS. PS DESIGN FLOW 480gpd L.T.A.R. no 35

Septic Tank: 1000 Gallons; STB 994 Date 10/31/95

Pump Tank: Gallons; PT Date

Pump Make: Model Serial No.

Nitrification Field: No Fields 1 Square Feet 1440 Linear Feet 480

No Lines 4@120' Trench Width 36" Max Trench Bottom Depth ≈30" Gravel Depth 12"

☑ New System ☐ Repair System Type: I, II, III, IV, V, VI

System Description: gravity conventional

Repair System Description: gravity pumped Infiltrator

Maintenance Agreement Required: ☐ Yes ☑ No

☑ House/Mod. Home ☐ Mobile Home ☐ Business ☐ Other

No. Bedrooms 4 No. Bathrooms 2½ No. Employees

☐ Slab ☑ Crawl Space ☐ Basement w/plumbing ☐ Basement wo/plumbing


Water Supply: ☑ Individual ☐ Community ☐ Public

Comments:

Comments: 1/29/96 - S/T and right half of drainfield approved - A.S
1/30/96 - Installed as shown on orig Permit

1" ≈ 100'

INITIAL SITE SKETCH

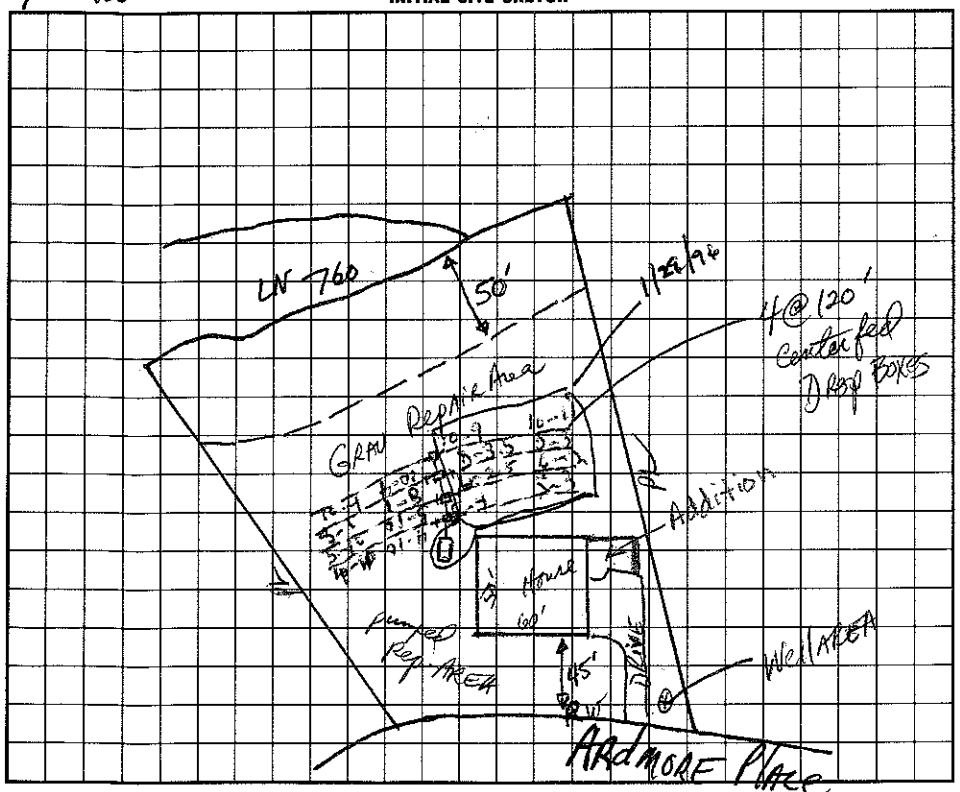

AS BUILT SKETCH

Location of the proposed Kitchen & Deck addition does not appear to impact the existing on-site septic system.**NOTE:

Judy Melville REHS

Date: 8-19-11

ICHD-Environmental Health Division

I understand that this permit can be suspended or revoked if any false information is supplied toward securing the permit/any unauthorized changes are made to the site/any unauthorized changes are made in the installation of the system.

Signed:

Improvement Permit by: date 8-11-95

Existing System Inspection by: date

Installed by: F J Erwin

Certificate of Completion by: date

Operation Permit by: RS date 1/30/96

HEALTH DEPT. COPY: WHITE INSPECTION COPY (FINAL): GREEN OWNER COPY (FINAL): YELLOW INSPECTION COPY (INITIAL): PINK OWNER COPY (INITIAL): GOLD