IREDELL COUNTY HEALTH DEPARTMENT

STATESVILLE 704-878-5305 MOORESVILLE 704-664-5281

IMPROVEMENT PERMIT / AUTHORIZATION TO CONSTRUCT / OPERATION PERMIT / EXISTING SYSTEM INSPECTION

PERMIT# 092477 PIN# ~~4626 38 7480 PT~~ 4626-39-5645 DATE 9-25-00

OWNER OR CONTRACTOR EASTER DEVELOP. CORP. PHONE: Business 664-2906 Home

ADDRESS 227 Hide Away Lane Mooresville NC 28117

LOCATION Brawley School, R. McKendree, ON RT

SUBDIVISION Blackberry Creek BLOCK / SECTION II LOT 16 LOT AREA 1.15 Acre SITE CLASS. RS DESIGN FLOW 360GPD L.T.A.R. .3640/FT²

Septic Tank: 1000 Gallons; STB 1007 Date 1/24/02

Pump Tank: Gallons; PT Date

Pump Make: Model Serial No.

Nitrification Field: No Fields 1 Square Feet 900 Linear Feet 300

No Lines 4@75' Trench Width 36" Max Trench Bottom Depth 36" Gravel Depth N/A

☒ New System ☐ Repair System Type: I, II, III, IV, V, VI

System Description: GRAVITY 25% REDUCTION

Repair System Description: GRAV. PANEL

Maintenance Agreement Required: ☐ Yes ☑ No

☒ House/Mod. Home No. Bedrooms 3

☐ Mobile Home No. Bathrooms 2½

☐ Business No. Employees

☐ Other


☐ Slab ☑ Crawl Space ☐ Basement w/plumbing ☐ Basement wo/plumbing

Water Supply: ☒ Individual ☐ Public ☐ Community


Comments:/Conditions: REMOVE TERRACES AND BERMS.

Comments:/Conditions:

INITIAL SITE SKETCH 1"=50'

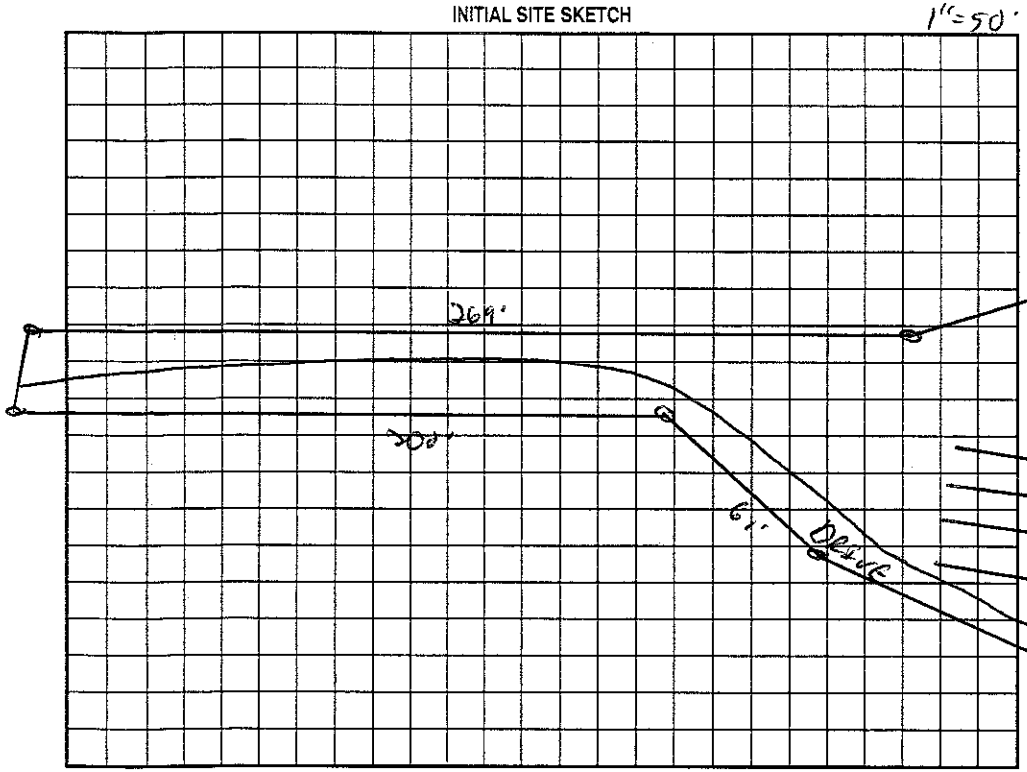

AS BUILT SKETCH

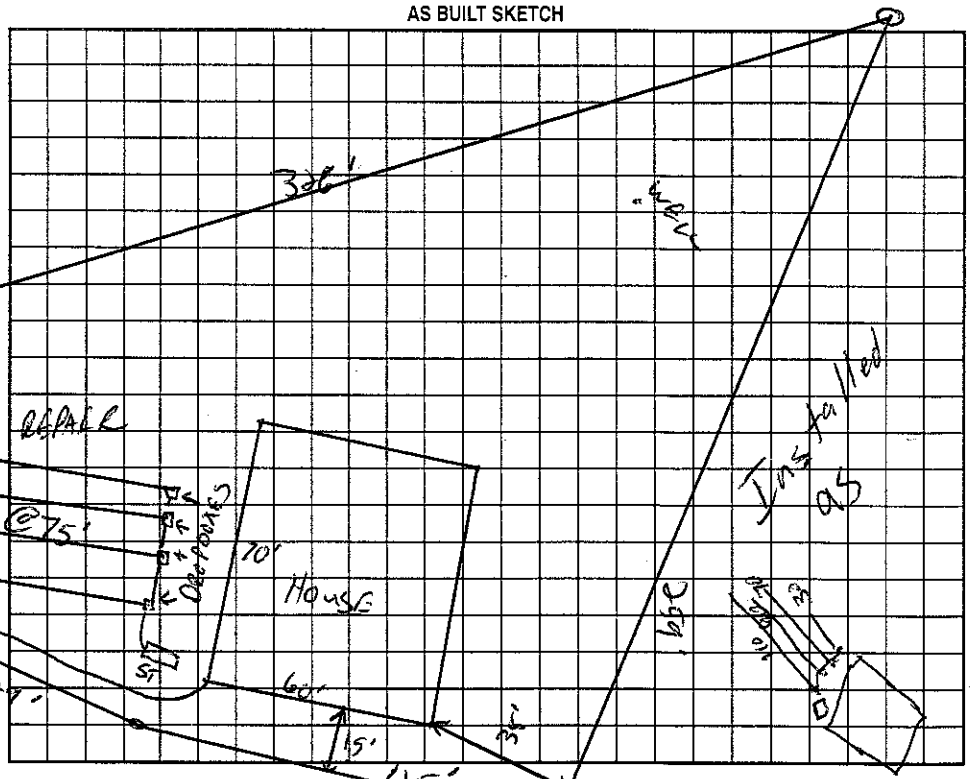

Permit can be suspended or revoked if any false information is supplied toward securing the permit/any unauthorized changes are made to the site/any unauthorized changes are made in the installation of the system. Improvement Permit with plat valid without expiration. Improvement Permit with site plan valid for sixty months. Authorization to Construct is valid for a period equal to that of Improvement Permit – not to exceed sixty months.

Signed: date 9-25-00 Installed by: Travis Enterprises

Improvement Permit by: date 11/7/00 Operation Permit by: date 3/8/02

Authorization to Construct by: date 10/30/01 Existing System Inspection by: date

HEALTH DEPT. COPY: WHITE OWNER COPY (FINAL): YELLOW OWNER COPY (INITIAL): PINK