10.00

MOORESVILLE 704-664-5281

...T / OPERATION PERMIT / EXISTING SYSTEM INSPECTION

PERMIT# ____ ...0 PT PIN# 4626-39-6447

OWNER OR CONTRACTOR EASTER DEVELOPMENT CORP. PHONE: Business ____ Home ____ DATE 12/20/99

ADDRESS 227 Hidaway Ln. Mooresville NC 28117

LOCATION R. Brawley School, R. McKendree R. Ardmore - 2nd on RT

SUBDIVISION Blackberry Creek BLOCK / SECTION 1 LOT 14 LOT AREA .86 AC SITE CLASS. 1S DESIGN FLOW 360 GPD L.T.A.R. - 3 GPD/FT²

Septic Tank: 1000 Gallons; STB 1007 Date 5/18/00

Pump Tank: ____ Gallons; PT ____ Date ____

Pump Make: ____ Model ____ Serial No. ____

Nitrification Field: No Fields 1 Square Feet 1200 Linear Feet 400

No Lines 5 @ 80' Trench Width 36" Max Trench Bottom Depth 36" Gravel Depth 12"

☒ New System ☐ Repair System Type: I (II) III, IV, V, VI

System Description: GRAVITY CONVENTIONAL

Repair System Description: GRAVITY 35% REDUCTION

Maintenance Agreement Required: ☐ Yes ☒ No

☒ House/Mod. Home No. Bedrooms 3

☐ Mobile Home No. Bathrooms 2

☐ Business No. Employees ____

☐ Other ____


☐ Slab ☐ Crawl Space ☒ Basement w/plumbing ☐ Basement wo/plumbing

Water Supply: ☒ Individual ☐ Public ☐ Community

Comments:/Conditions: KEEP WELL 100' FROM SEPTIC SYSTEM - (SAPROLITE SOILS) ##

Comments:/Conditions:

INITIAL SITE SKETCH

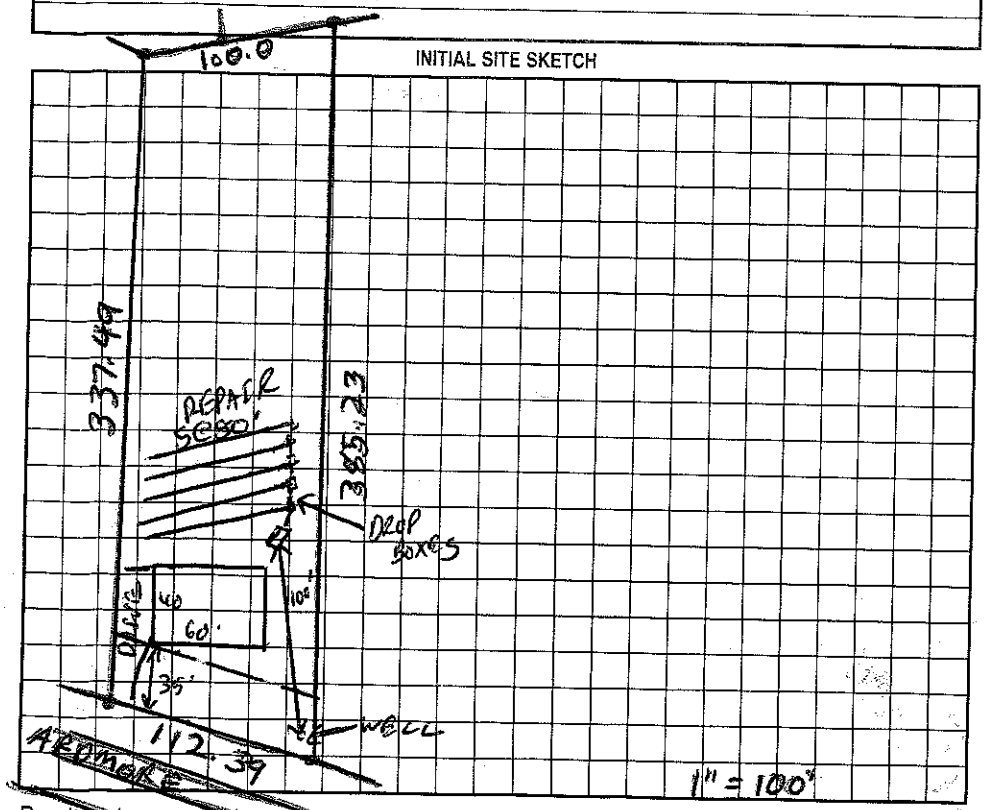

AS BUILT SKETCH

Permit can be suspended or revoked if any false information is supplied toward securing the permit/any unauthorized changes are made to the site/any unauthorized changes are made in the installation of the system. Improvement Permit with plat valid without expiration. Improvement Permit with site plan valid for sixty months. Authorization to Construct is valid for a period equal to that of Improvement Permit – not to exceed sixty months.

Signed: ____ PRES EDC date 12/21/99

Improvement Permit by: ____ date 12/20/99

Authorization to Construct by: ____ RS date 1/13/00

Installed by: WAYNE CLONZ

Operation Permit by: ____ date 7/21/00

Existing System Inspection by: ____ date ____

HEALTH DEPT. COPY: WHITE OWNER COPY (FINAL): YELLOW OWNER COPY (INITIAL): PINK