IREDELL COUNTY HEALTH DEPARTMENT

STATESVILLE 704-878-5305 155.00 Paid MOORESVILLE 704-664-5281

IMPROVEMENT PERMIT / AUTHORIZATION TO CONSTRUCT / OPERATION PERMIT / EXISTING SYSTEM INSPECTIO

PERMIT# 086518 PIN# ~~4626 35 7480 PT~~ 4626-59-7420 DATE 3/11/03

OWNER OR CONTRACTOR LEWIS CARPENTER PHONE: Business 664-2906 Home

ADDRESS 237 HIDEAWAY LN MOORESVILLE

LOCATION BRAWLEY SCHOOL - TR MCKENOREE - TR ARDMORE - ON CORNER

SUBDIVISION BLACKBERRY CREEK BLOCK / SECTION 1 LOT 13 LOT AREA .92AC SITE CLASS. PS DESIGN FLOW 480GPD L.T.A.R. .3680/R-2

Septic Tank: 1000 Gallons; STB 312 Date 7/1/02

Pump Tank: Gallons; PT Date

Pump Make: Model Serial No.

Nitrification Field: No Fields 1 Square Feet 1200 Linear Feet 400

No Lines 5@80' Trench Width 36" Max Trench Bottom Depth 36" Gravel Depth N/A

☑ New System ☐ Repair System Type: I, II, III, IV, V, VI

System Description: GRAVITY 25% REDUCTION

Repair System Description: SAME

Maintenance Agreement Required: ☐ Yes ☑ No

☑ House/Mod. Home ☐ Mobile Home ☐ Business ☐ Other

No. Bedrooms 4 No. Bathrooms 4 No. Employees


Water Supply: ☑ Individual ☐ Public ☐ Community

☐ Slab ☑ Crawl Space ☐ Basement w/plumbing ☐ Basement wo/plumbing

Comments:/Conditions:

Comments:/Conditions:

INITIAL SITE SKETCH 1" = 100'

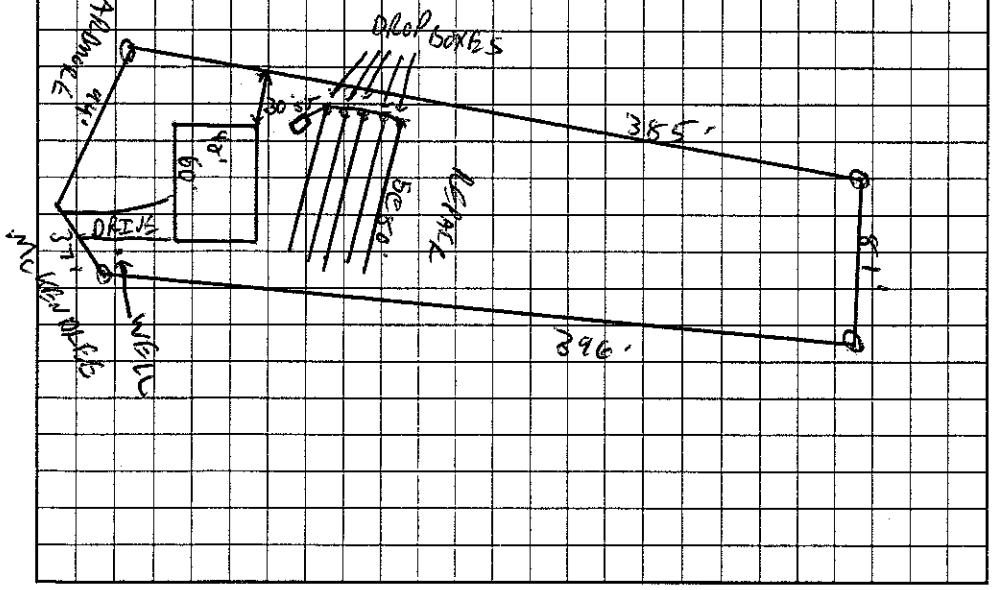

AS BUILT SKETCH

Installed As Drawn Infiltrators

Permit can be suspended or revoked if any false information is supplied toward securing the permit/any unauthorized changes are made to the site/any unauthorized changes are made in the installation of the system. Improvement Permit with plat valid without expiration. Improvement Permit with site plan valid for sixty months. Authorization to Construct is valid for a period equal to that of Improvement Permit – not to exceed sixty months.

Signed: Lewis F Carter date 3-17-03 Installed by: Larry Beam

Improvement Permit by: C. [illegible] RS date 3/11/03 Operation Permit by: [illegible] RS date 3/13/03

Authorization to Construct by: C. [illegible] RS date 3/11/03 Existing System Inspection by: date

HEALTH DEPT. COPY: WHITE OWNER COPY (FINAL): YELLOW OWNER COPY (INITIAL): PINK

IREDELL COUNTY HEALTH DEPARTMENT

STATESVILLE 704-878-5305 MOORESVILLE 704-664-5281

IMPROVEMENT PERMIT / AUTHORIZATION TO CONSTRUCT / OPERATION PERMIT / EXISTING SYSTEM INSPECTION

PERMIT# 86518 PIN# 4626387480 PT

OWNER OR CONTRACTOR EASTER DEVELOPMENT CORP PHONE: Business 664-2906 Home 201-6465 DATE 12/20/99

ADDRESS 227 Hideaway Ln Mooresville NC 28117

LOCATION R. Brawley School, R McKendree - TR ARDMORE - ON CORNER

SUBDIVISION Blackberry Creek BLOCK / SECTION 1 LOT 13 LOT AREA .92 ac SITE CLASS. PS DESIGN FLOW 360GPD L.T.A.R. .30GPD/FT²

Septic Tank: 1000 Gallons; STB ____ Date ____

Pump Tank: ____ Gallons; PT ____ Date ____

Pump Make: ____ Model ____ Serial No. ____

Nitrification Field: No Fields 1 Square Feet 1900 Linear Feet 400

No Lines 5@80' Trench Width 36" Max Trench Bottom Depth 36" Gravel Depth 12"

☒ New System ☐ Repair System Type: I (II) III, IV, V, VI

System Description: GRAVITY CONVENTIONAL

Repair System Description: SAME

Maintenance Agreement Required: ☐ Yes ☒ No

☒ House/Mod. Home ☐ Mobile Home ☐ Business ☐ Other


No. Bedrooms 3 No. Bathrooms 2 No. Employees ____

☐ Slab ☐ Crawl Space ☒ Basement w/plumbing ☐ Basement wo/plumbing

Water Supply: ☒ Individual ☐ Public ☐ Community


Comments:/Conditions:

INITIAL SITE SKETCH

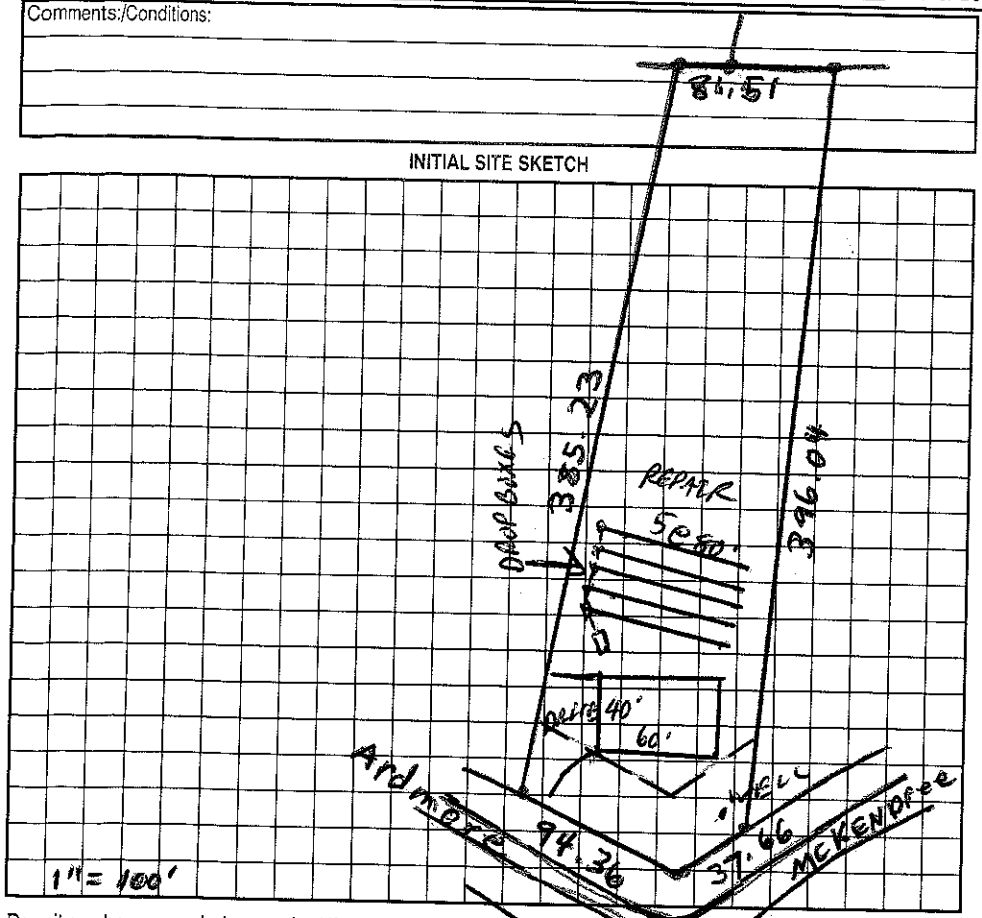

Comments:/Conditions:

AS BUILT SKETCH

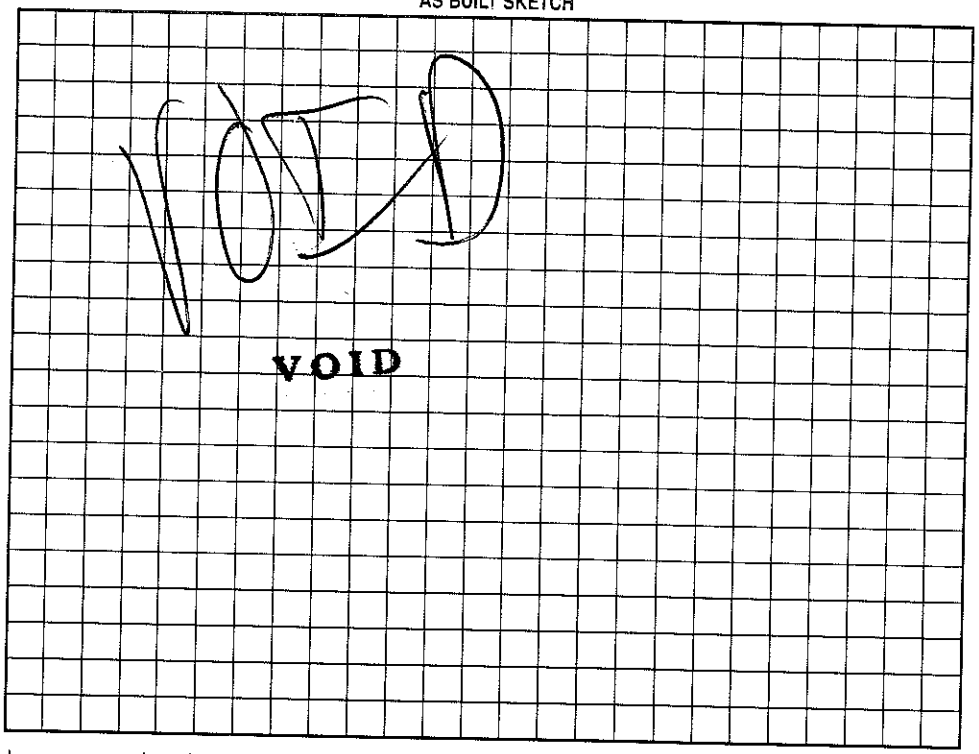

Permit can be suspended or revoked if any false information is supplied toward securing the permit/any unauthorized changes are made to the site/any unauthorized changes are made in the installation of the system. Improvement Permit with plat valid without expiration. Improvement Permit with site plan valid for sixty months. Authorization to Construct is valid for a period equal to that of Improvement Permit – not to exceed sixty months.

Signed: [signature] - PRES EDC date 12/21/99

Improvement Permit by: [signature] RS date 12/20/99

Authorization to Construct by: [signature] RS date 1/13/00

Installed by: ____

Operation Permit by: ____ date ____

Existing System Inspection by: ____ date ____

HEALTH DEPT. COPY: WHITE OWNER COPY (FINAL): YELLOW OWNER COPY (INITIAL): PINK