# IREDELL COUNTY HEALTH DEPARTMENT

STATESVILLE 704-878-5305 MOORESVILLE 704-664-5281

1:30

## IMPROVEMENT PERMIT / AUTHORIZATION TO CONSTRUCT / OPERATION PERMIT / EXISTING SYSTEM INSPECTION

PERMIT# 86506 PIN# ~~4626 35 7480~~ 4626-39-7865 DATE 12/20/99

OWNER OR CONTRACTOR EASTER DEVELOPMENT PHONE: Business 664-2906 Home

ADDRESS 227 HIDEAWAY LN MOORESVILLE NC 28117

LOCATION BRAWLEY SCHOOL RD - TR McKENDREE - TR OLD CREEK - TL BARKSDALE - 5TH ON LT

SUBDIVISION BLACKBERRY CK BLOCK / SECTION LOT 1 LOT AREA .73AC SITE CLASS. PS DESIGN FLOW 360 L.T.A.R. .3 gpd/ft²

Septic Tank: 1000 Gallons; STB 825 Date 6-15-00

Pump Tank: [redacted] Gallons; PT Date

Pump Make: Model Serial No. 280'

Nitrification Field: No Fields 1 Square Feet 900 Linear Feet 300

No Lines ~~5 660'~~ 4 Trench Width 36" Max Trench Bottom Depth 36" Gravel Depth N/A

☒ New System ☐ Repair System Type: I, II, III, IV, V, VI

System Description: GRAVITY 25% REDUCTION

Repair System Description: GRAV. PANEL

Maintenance Agreement Required: ☐ Yes ☒ No

☒ House/Mod. Home No. Bedrooms 3

☐ Mobile Home No. Bathrooms 2

☐ Business No. Employees

☐ Other


☐ Slab ☐ Crawl Space ☒ Basement w/plumbing ☐ Basement wo/plumbing

Water Supply: ☒ Individual ☐ Public ☐ Community


Comments:/Conditions: 4 at 70'

Comments:/Conditions: Installed Plastic Chamber in 4-70' lines, soil looked like .35 LTAR in most of trenches.

INITIAL SITE SKETCH 1"=50'

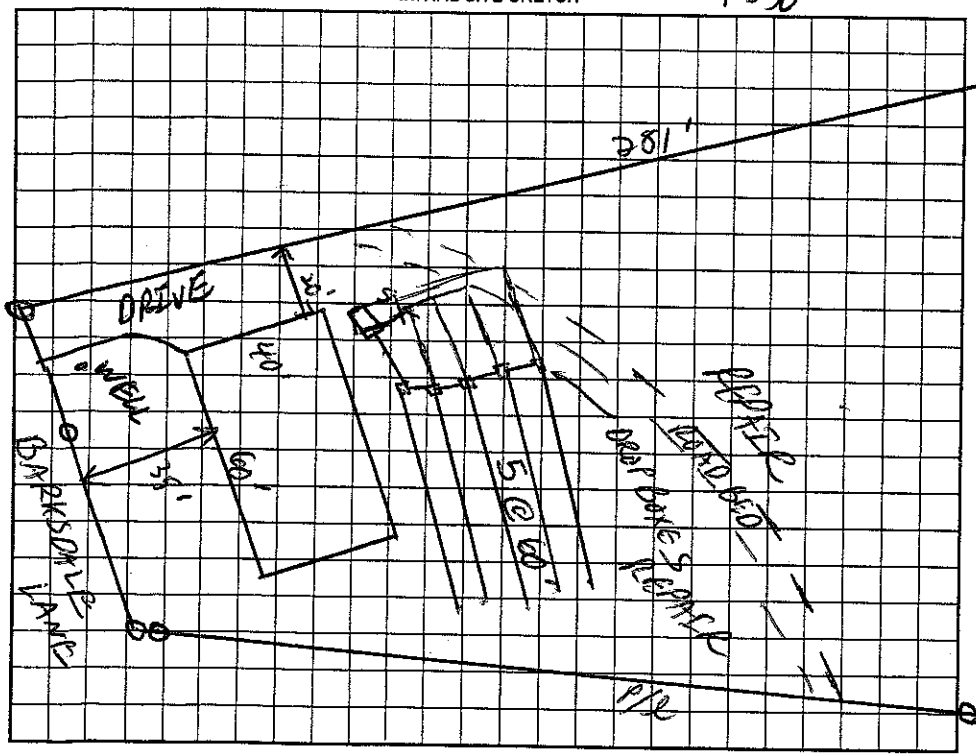


AS BUILT SKETCH

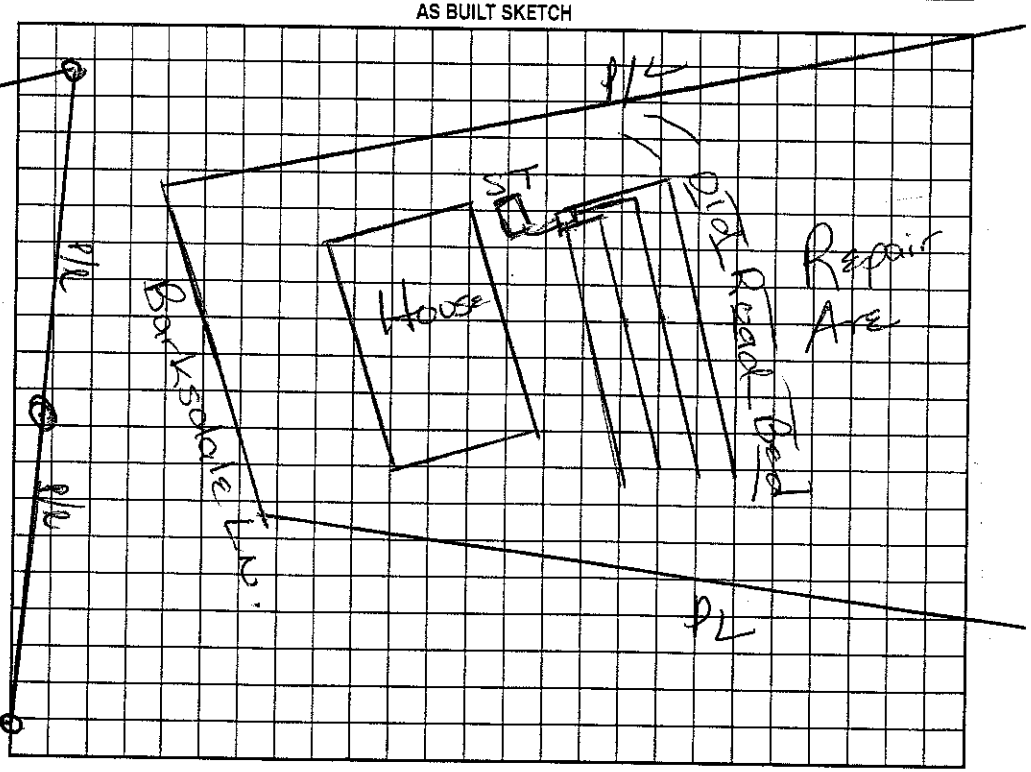


Permit can be suspended or revoked if any false information is supplied toward securing the permit/any unauthorized changes are made to the site/any unauthorized changes are made in the installation of the system. Improvement Permit with plat valid without expiration. Improvement Permit with site plan valid for sixty months. Authorization to Construct is valid for a period equal to that of Improvement Permit – not to exceed sixty months.

Signed Dr E.A. - PRES. EDC date 12/21/99 Installed by: WAYNE CRONTZ

Improvement Permit by: C. Byington RS date 12/20/99 Operation Permit by: Mariah Dotson RS date 8/18/2000

Authorization to Construct by: C. Byington RS date 1/3/00 Existing System Inspection by: date

HEALTH DEPT. COPY: WHITE OWNER COPY (FINAL): YELLOW OWNER COPY (INITIAL): PINK