# IREDELL COUNTY HEALTH DEPARTMENT

STATESVILLE 704-878-5305 MOORESVILLE 704-664-5281

## IMPROVEMENT PERMIT / AUTHORIZATION TO CONSTRUCT / OPERATION PERMIT / EXISTING SYSTEM INSPECTION

PERMIT# 86507 PIN# ~~4626367480AT~~ 4626-39-8746 DATE 12/20/99

OWNER OR CONTRACTOR EASTER DEVELOPMENT PHONE: Business 664-2906 Home

ADDRESS 227 HIDEAWAY LN MOORESVILLE 28117

LOCATION BRAWLEY SCHOOL - TL McKENDREE - TR DEER CIRCLE - TL BARKSDALE - 4TH ON LT

SUBDIVISION BLACKBERRY CRK BLOCK / SECTION LOT 2 LOT AREA 1.71AC SITE CLASS. PS DESIGN FLOW 360gpd L.T.A.R. .39gpd/sqft

Septic Tank: 1000 Gallons; STB 794 Date 3/14/03

Pump Tank: Gallons; PT Date

Pump Make: Model Serial No.

Nitrification Field: No Fields 1 Square Feet 900 Linear Feet 300

No Lines 4@75' Trench Width 36" Max Trench Bottom Depth 36" Gravel Depth N/A

☑ New System ☐ Repair System Type: I, II, III, IV, V, VI

System Description: GRAVITY 25% REDUCTION

Repair System Description: SAME

Maintenance Agreement Required: ☐ Yes ☑ No

☑ House/Mod. Home No. Bedrooms 3

☐ Mobile Home No. Bathrooms 2

☐ Business No. Employees

☐ Other


☐ Slab ☑ Crawl Space ☑ Basement w/plumbing ☐ Basement wo/plumbing

Water Supply: ☑ Individual ☐ Public ☐ Community


Comments:/Conditions:

Comments:/Conditions:

INITIAL SITE SKETCH 1"=50'

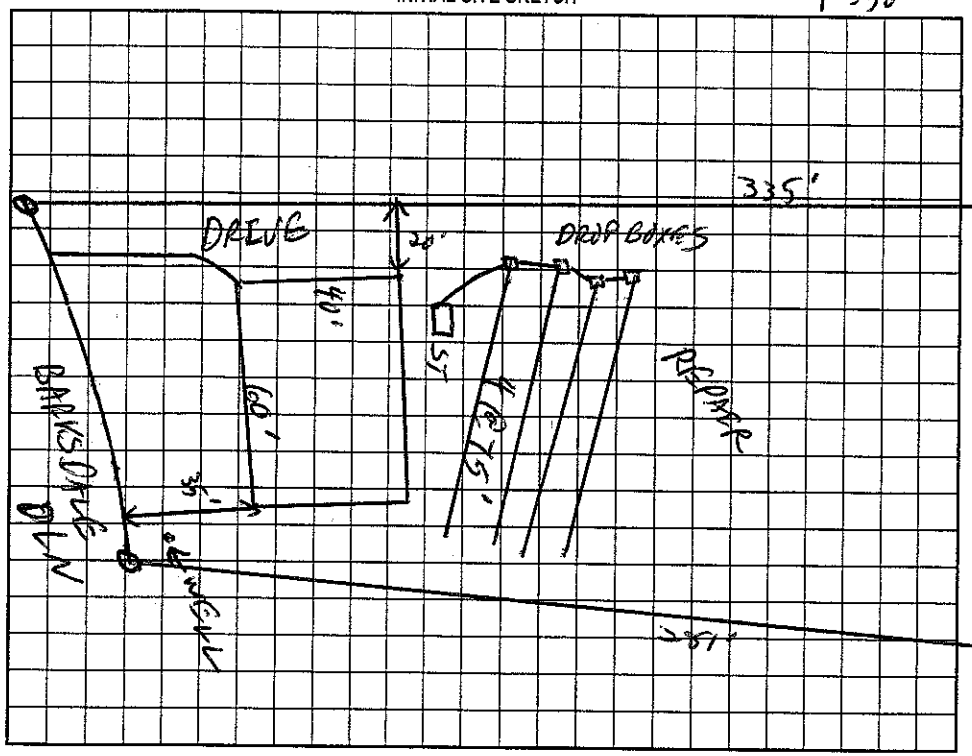


AS BUILT SKETCH

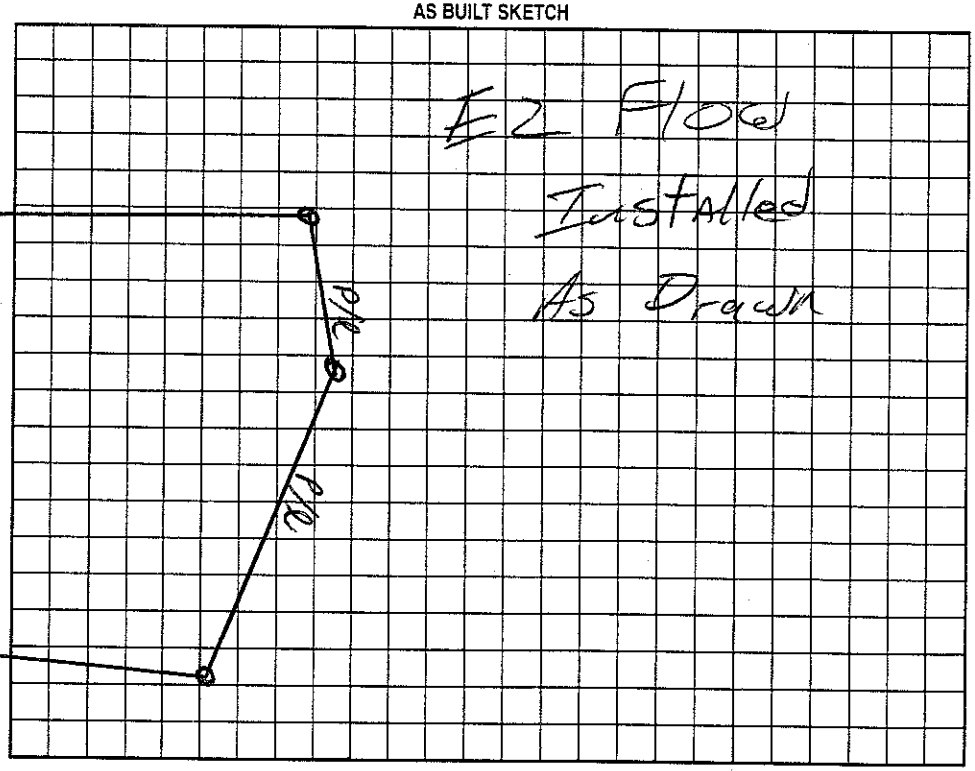


Permit can be suspended or revoked if any false information is supplied toward securing the permit/any unauthorized changes are made to the site/any unauthorized changes are made in the installation of the system. Improvement Permit with plat valid without expiration. Improvement Permit with site plan valid for sixty months. Authorization to Construct is valid for a period equal to that of Improvement Permit – not to exceed sixty months.

Signed: [signature] - PIRES EDC date 12/21/99

Improvement Permit by: [signature] RS date 12/20/99

Authorization to Construct by: [signature] RS date 1/13/00

Installed by: Larry Beam

Operation Permit by: [signature] RS date 4/16/03

Existing System Inspection by: date

HEALTH DEPT. COPY: WHITE OWNER COPY (FINAL): YELLOW OWNER COPY (INITIAL): PINK